

Name Four Star Realty Trust

Service No. 92

Address 105 Blossomcrest Rd.

Location

Kind of Pipe

Size

Size of Main

~~Repair~~ ~~Amount~~ - New Service W. O. # 9827

Location


Date	Material	Amount	Total	Date	Amount	
7/6/72	Labor	109 45		6-20-72	Deposit	250 00
8/25/72	"	62 88		12-18-72	Paid by DHP #30	41 92
	10% O.H.	17 23	189 56	12-29-72	Paid	39 10
	20' 6" Transite ppe @ .90		18 00			<u>331 02</u>
	1 3' Nipple		4 00			
	1 90o Elbow		5 65			
	1 8x6 Saddle		15 95			
	1 6" Plug		2 38			
	6 Ton stone 1.90		11 40			
	4 " gravel @ 1.90		7 60			
	1 Bag cement 1.98		1 98			
	1 1/2 Ton Cold patch 8.00		12 00			
	2 " Hot top 8.00		16 00			
	4 Hrs. Trucking 3.00		12 00			
	2 " Shovel 6.50		13 00			
	2 1/2 " Compressor 5.00		12 50			
	1 " Loader		5 00			
	1 " Roller Trailer		2 00			
			2 00			
			<u>331 02</u>			
7/20/72	32' 6" Transite					
	10' 4" Cast Iron					

DATE _____

TOWN OF LEXINGTON — BOARD OF PUBLIC WORKS
SEWER DIVISION

Sketch of Service Here

105

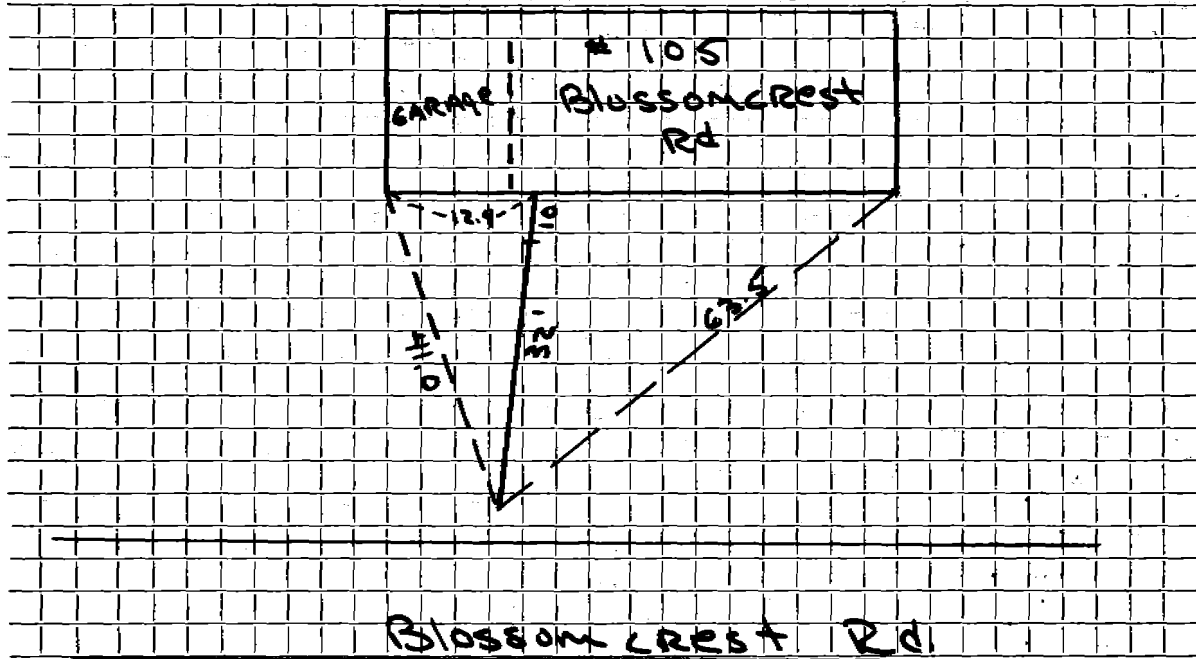

Connection made in Street. Work completed

Remarks:

.....

.....