

Name Peter Gaillard

Service No. 39

Address 106 Blossomcrest Road

Location

Kind of Pipe

Size

Size of Main

~~Repair~~ ~~Work~~ - New Service W.O. #3325. *Eagle #2481*


Location *Comm 7-28-75*

Date	Material	Amount	Total	Date	Amount
5-13-75	Labor 23.57			<i>5-9-75</i>	<i>Deposit</i> 400.00
5-22-75	Labor 82.99	\$106.56		<i>7-28-75</i>	<i>Retend</i> 146.17
	10% O.H.	10.66	\$ 117.22		253.83
	10' 6" Transite Pipe @1.27/Ft.		12.70		NON-CHARGE
	2 5' x 6" Nip @1.48/Ft.		14.80	5-22-75	Labor \$ 47.42
	1 6" x 8" Saddle		20.42		
	1 1 1/2" El		3.94		
	1 Patch 4'x18'		48.00		
	2 Hrs. Trucking @3.00		6.00		
	2 Hrs. Pick up @1.50		3.00		
	3 1/2 Hrs. Backhoe @6.50		22.75		
	1 Hr. Compressor @5.00		5.00		
			\$ 253.83		

DATE _____

TOWN OF LEXINGTON — BOARD OF PUBLIC WORKS
SEWER DIVISION

Sketch of Service Here

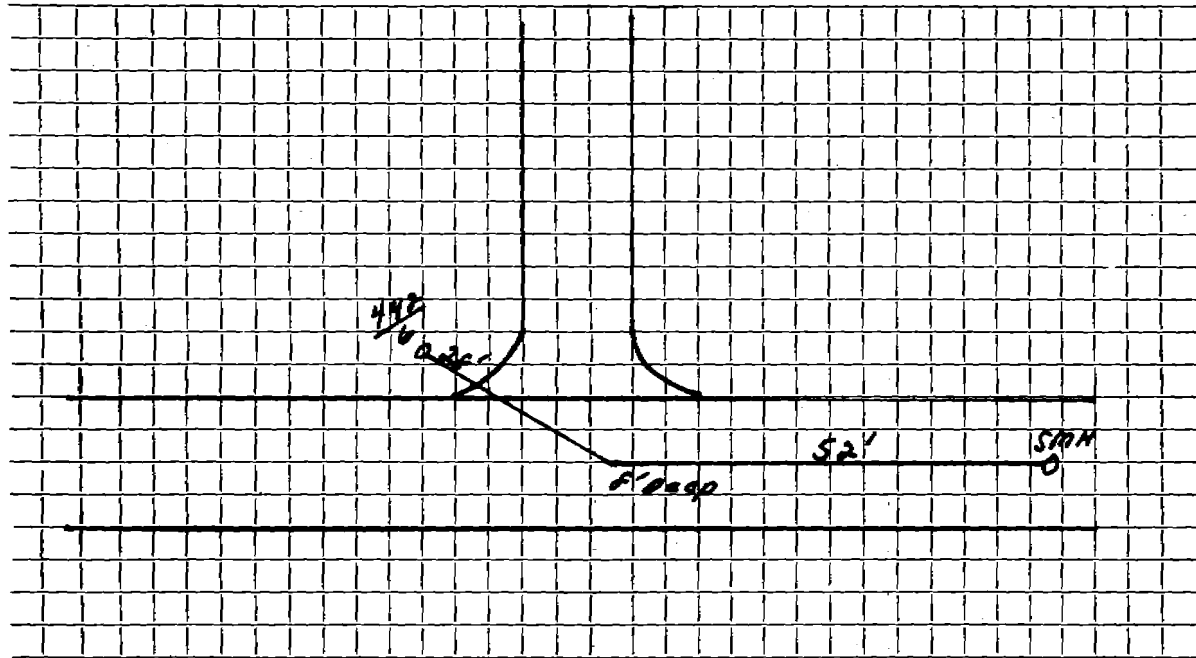

Connection made in Street. Work completed

Remarks:
.....
.....