

Name Four Star Realty Trust

Service No. 93

Address 107 Blossomcrest Rd

Location

Kind of Pipe

Size

Size of Main

~~Repair~~ ~~Renewal~~ New Service

W.O. # 9828

Location


Date	Material	Amount	Total	Date	Amount
7/6/72	La bor	85 71		6-30-75	Deposit
8/25/72	"	62 88		12-18-75	Paid by W.H.A.#31
10%	O.H.	14 86	163 45	12-29-72	Paid
20'	6" Transite pipe .90		18 00		# 304 06
1	3'-Nipple		4 00		
1	90o Elbow		5 65		
1	8x6 Saddle		15 95		
1	6" Plug		2 38		
1	Bag Cement		1 98		
7	Ton Stone 1.90		13 30		
4	" Gravel 1.90		7 60		
2	" Cold Patch 8.00		16 00		
2	" Hot top 8.00		16 00		
4	Hrs. Truck 3.00		12 00		
1/2	" " 1.50		75		
2	" Shovel 6.50		13 00		
1	" Loader		5 00		
1	" Compressor		5 00		
1	" Roller Trailer		2 00		
			)))2 00		
			304 06		
7/20/72	35' 6" Transite				
10'	4" Cast Iron				

DATE \_\_\_\_\_

TOWN OF LEXINGTON — BOARD OF PUBLIC WORKS

SEWER DIVISION

Sketch of Service Here **107**

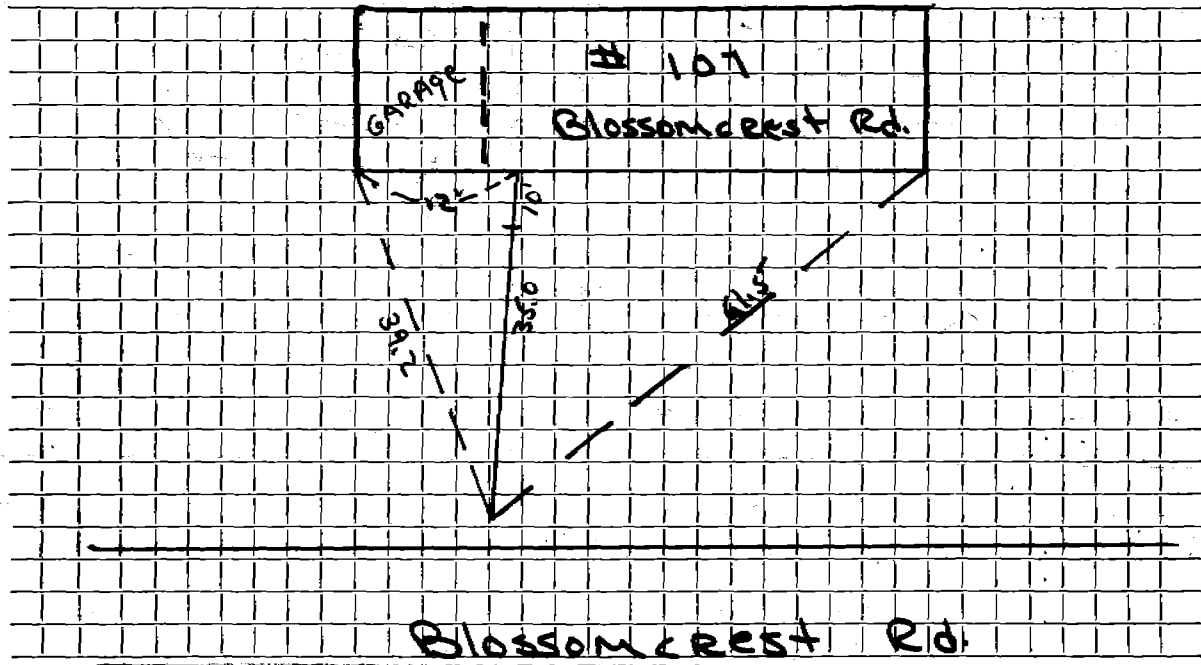

Connection made in ..... Street. Work completed .....

Remarks: .....  
.....  
.....