

Name **Clarissa Youens**

Service No. **64**

Address **#12 Blossomcrest Rd.**

Location

**NOV 24 1980**

Kind of Pipe **A.C.**

Size **6"**

Size of Main **8"**

~~XXXXXXXXXXXX~~ **New Service** **Trebino #3544**

Location


Date		Material	Amount	Total	Date	Amount
6-21	77	26'-6" AC P	\$10.00	\$260.00	11-21-80	Deposit 260.00
12-8-80	29'	P.V.C. pipe				
	2	20° Bends				
	5'	Iron				

DATE \_\_\_\_\_

TOWN OF LEXINGTON — BOARD OF PUBLIC WORKS  
SEWER DIVISION

Sketch of Service Here

12

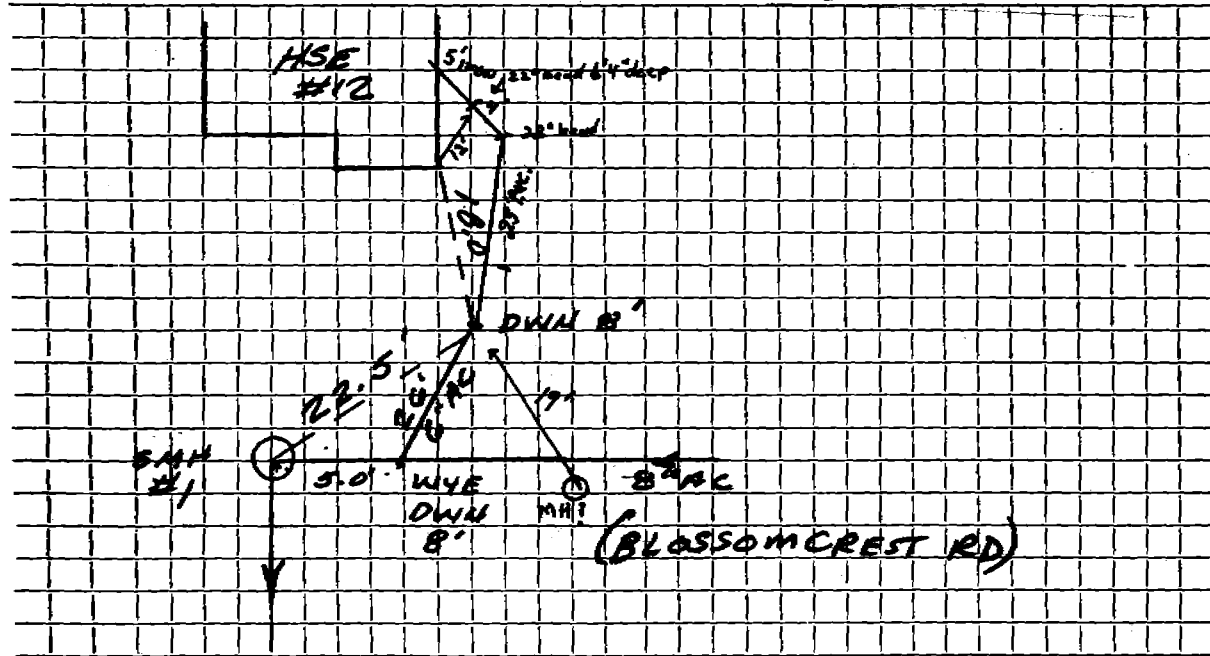

Connection made in ..... Street. Work completed .....

Remarks: .....  
.....  
.....