


DATE 8/4/92

TOWN OF LEXINGTON — BOARD OF PUBLIC WORKS
SEWER DIVISION

Sketch of Service Here

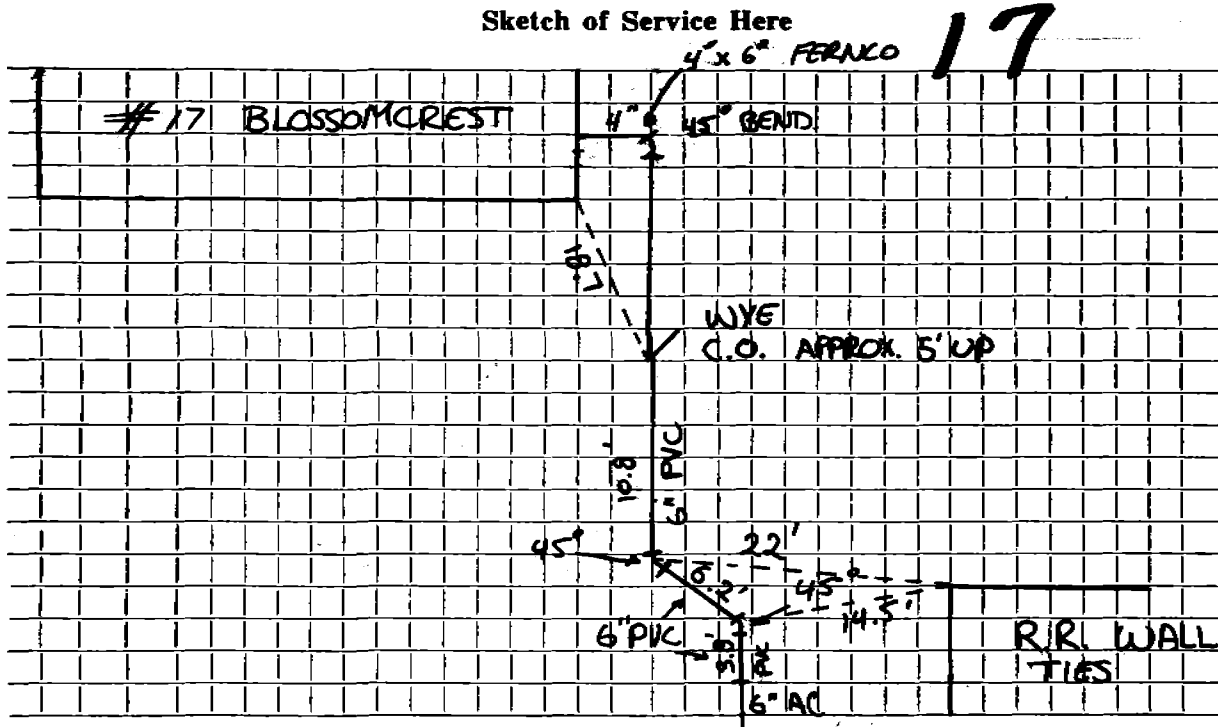

Connection made in Street. Work completed

Remarks: INSTALLED BY: KIRKLAND & SHAW
INSPECTED BY: S. MACKAY