




DATE .....

# TOWN OF LEXINGTON — BOARD OF PUBLIC WORKS SEWER DIVISION

Sketch of Service Here **26**

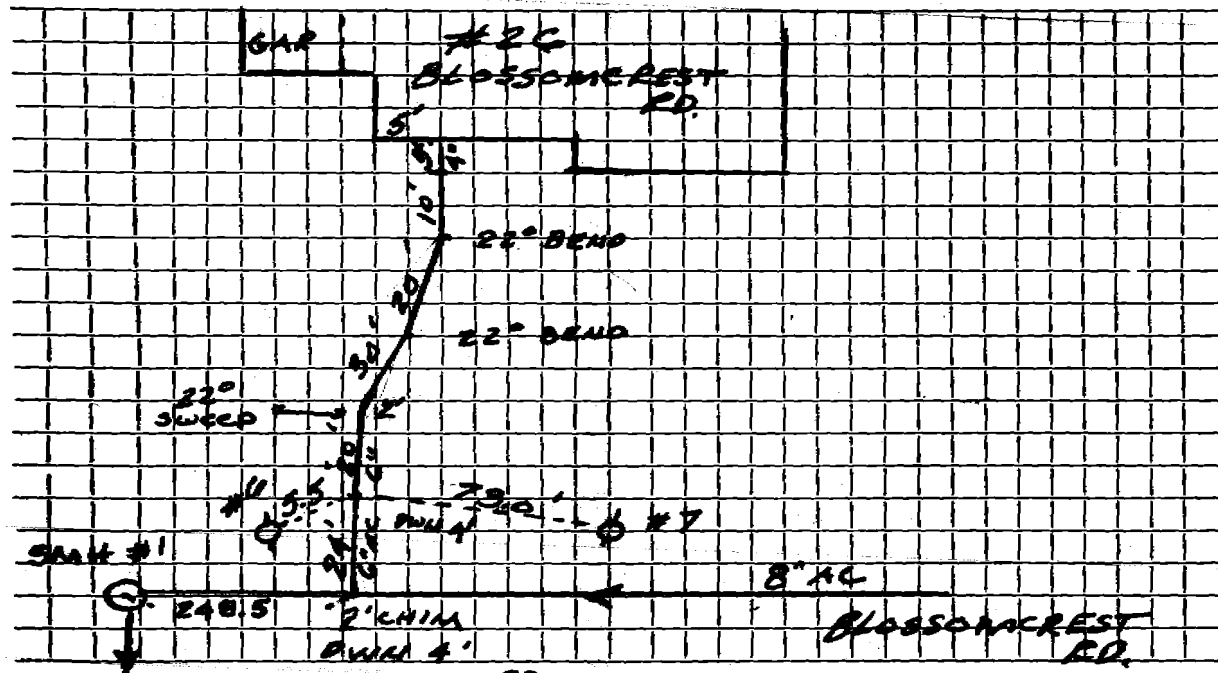

Connection made in BLOSSOMCREST RD Street Work completed .....

Remarks: .....