

Name **David G. Gil**

Service No. **55**

Address **# 29 Blossomcrest Rd.**

Location

Kind of Pipe **AC**

Size **6"**

Size of Main **8"**

Repair—Renewal—New Service **Trébino #3061**


Location **AUG 29 1977**

Date	Material	Amount	Total	Date	Description	Amount
6-14-77	13'-6" AC @	\$10.00	\$130 00	7/29/77	Deposit	130. —
8/8/77	40' 6" transite pipe					
	10' 4" cast iron					

DATE

TOWN OF LEXINGTON — BOARD OF PUBLIC WORKS
SEWER DIVISION

Sketch of Service Here **29**

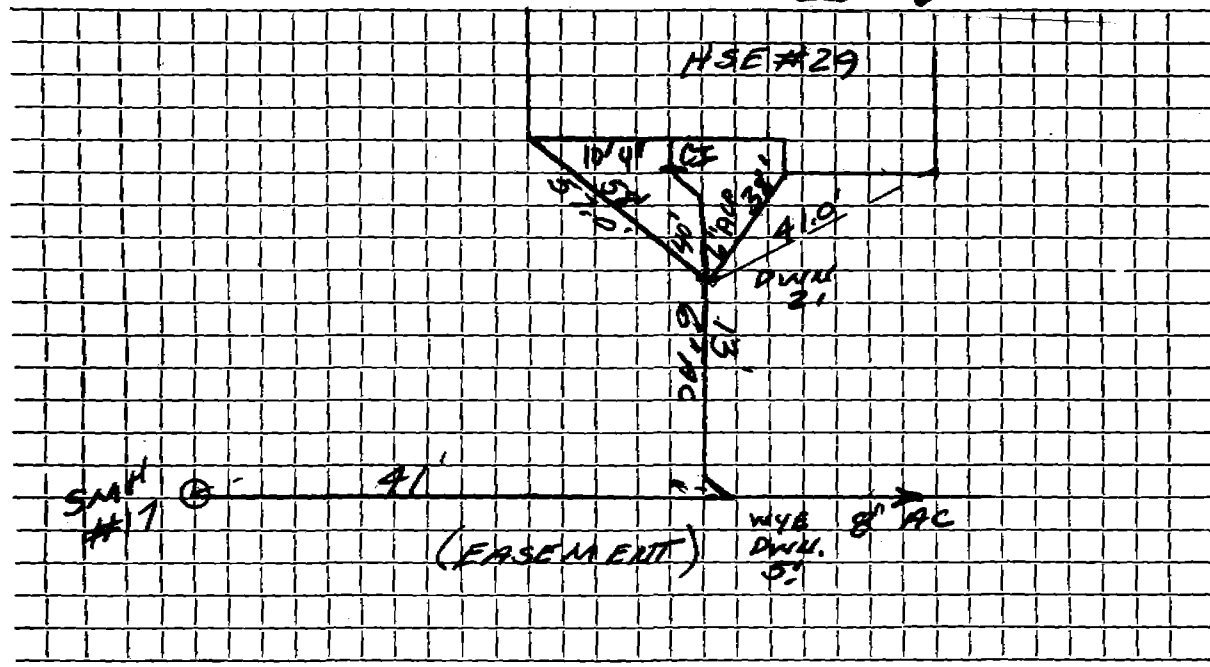

Connection made in Street. Work completed

Remarks:
.....
.....