




DATE 1/27/2020

TOWN OF LEXINGTON — BOARD OF PUBLIC WORKS  
SEWER DIVISION

Sketch of Service Here

#52

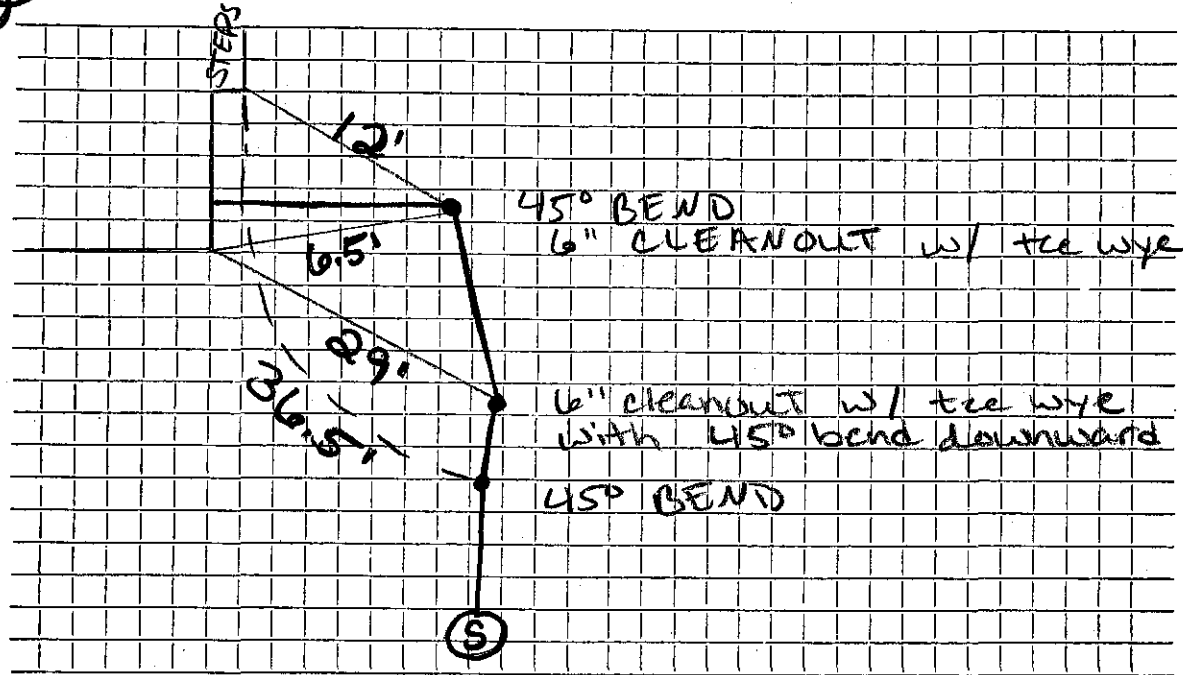

Connection made in Blossomcrest Street. Work completed .....

Remarks: Both cleanouts have tee wye