

Name

Service No.

Address 60 Blossomcrest Road

* 60 Blossomcrest Rd.

Location

Kind of Pipe

175

Size

Size of Main

Repair—Renewal—New Service

Location

Date

Material

Amount

Total

Date

Amount

1967

25' 6" Transite pipe @7.00

175.00

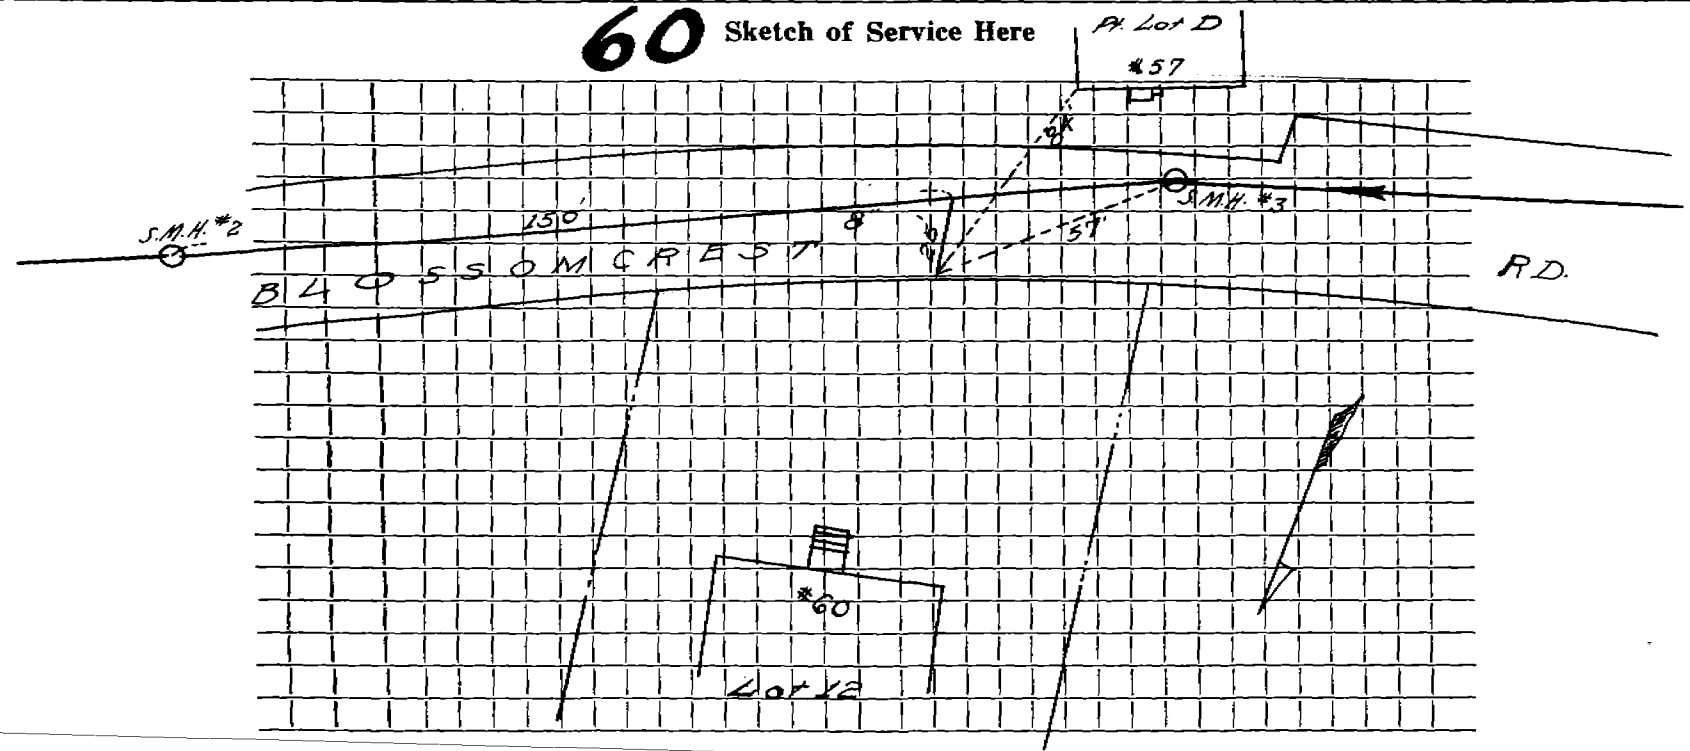
25' 6" Transite @7.00

DATE _____

TOWN OF LEXINGTON — BOARD OF PUBLIC WORKS

SEWER DIVISION

60

 Sketch of Service Here

Connection made in Street. Work completed

Remarks:
.....
.....