

Name Henry Kent

Service No. 76

Address 63 Blossomcrest Road

#63 Blossomcrest Rd

Location

Kind of Pipe 25

Size

Size of Main

Repair—Renewal—New Service Lexington Sewerage #1698

Location SEP 21 1970


Date	Material	Amount	Total	Date	Amount
1967	25' 6" Transite pipe @ 7.00		175.00	8-7-70	Deposit
8-14-70	19' 6" Transite pipe				
	16' 4" Cast Iron pipe				
	25' 6" Transite @ 7.00				

DATE \_\_\_\_\_

TOWN OF LEXINGTON — BOARD OF PUBLIC WORKS  
SEWER DIVISION

Sketch of Service Here

63

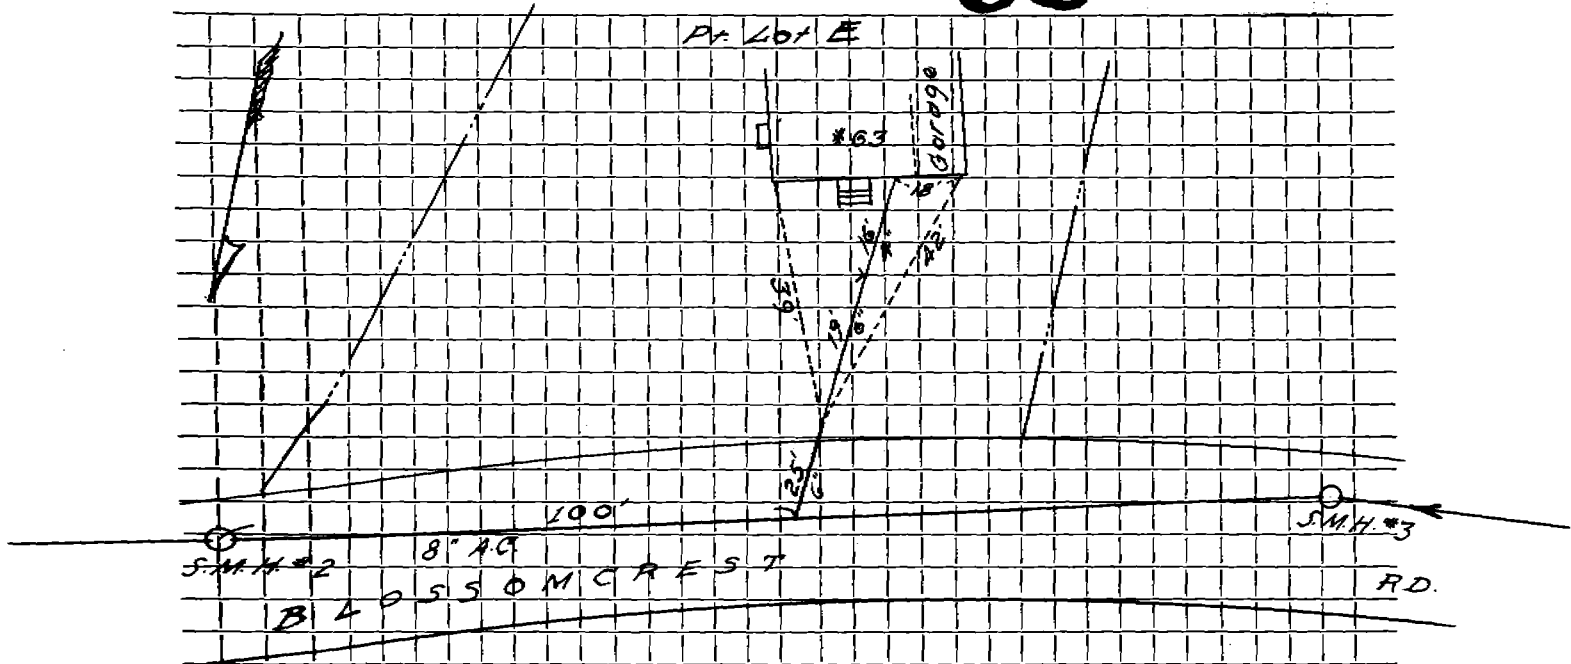

Connection made in ..... Street. Work completed .....

Remarks: .....  
.....  
.....