




DATE 9-17-2001

TOWN OF LEXINGTON — BOARD OF PUBLIC WORKS

SEWER DIVISION

Sketch of Service Here

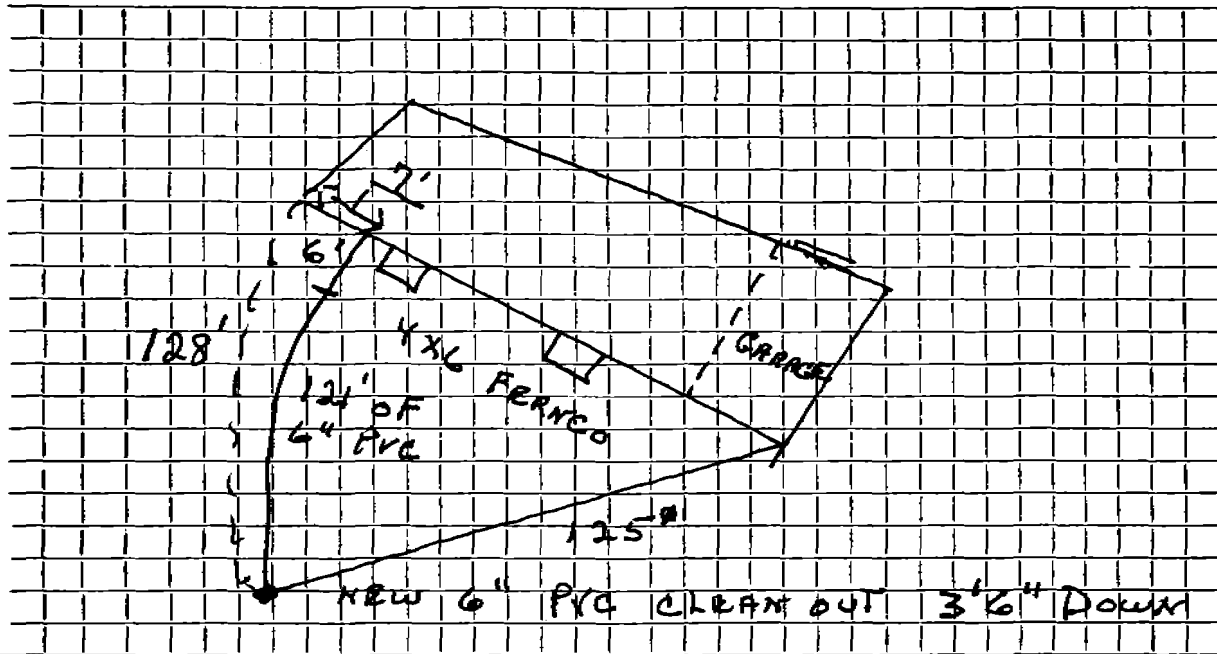

Connection made in BLOSSOM CREST Street. Work completed .....

Remarks: INSTALLED by J. McLAUGHLIN .....