

Name

Service No.

Address 70 Blossomcrest Road

#70 Blossomcrest Rd

Location

Kind of Pipe

Size

Size of Main

Repair—Renewal—New Service W.O. #5895


Location

Date		Material	Amount	Total	Date	Amount
1967	36'	6" Transite pipe @7.00		252.00		
		SERVICE EXTENDED				
11/13/67		Labor	23 02			
		10% O.H.	2 39	29 28		
	3'	6" transite pipe @ .88		2 64		
	1	Hr. Trucking		3 00		
	1	Hr. Shovel		6 50		
		BILL WHEN CONNECTED		293 86		
				545 86		

DATE _____

TOWN OF LEXINGTON — BOARD OF PUBLIC WORKS
SEWER DIVISION

Sketch of Service Here **70**

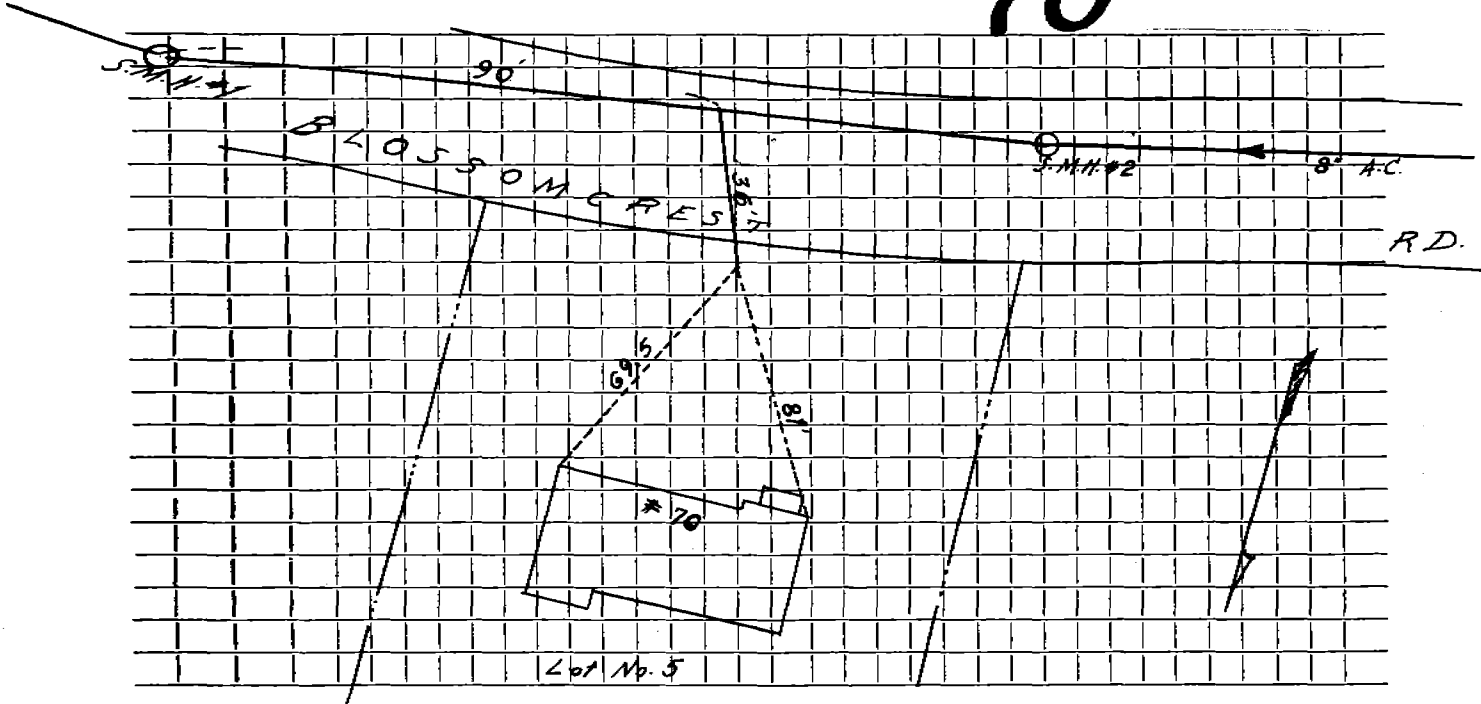

Connection made in Street. Work completed


Remarks:
.....
.....

DATE DEC 12 1998

TOWN OF LEXINGTON — BOARD OF PUBLIC WORKS

SEWER DIVISION

Sketch of Service Here

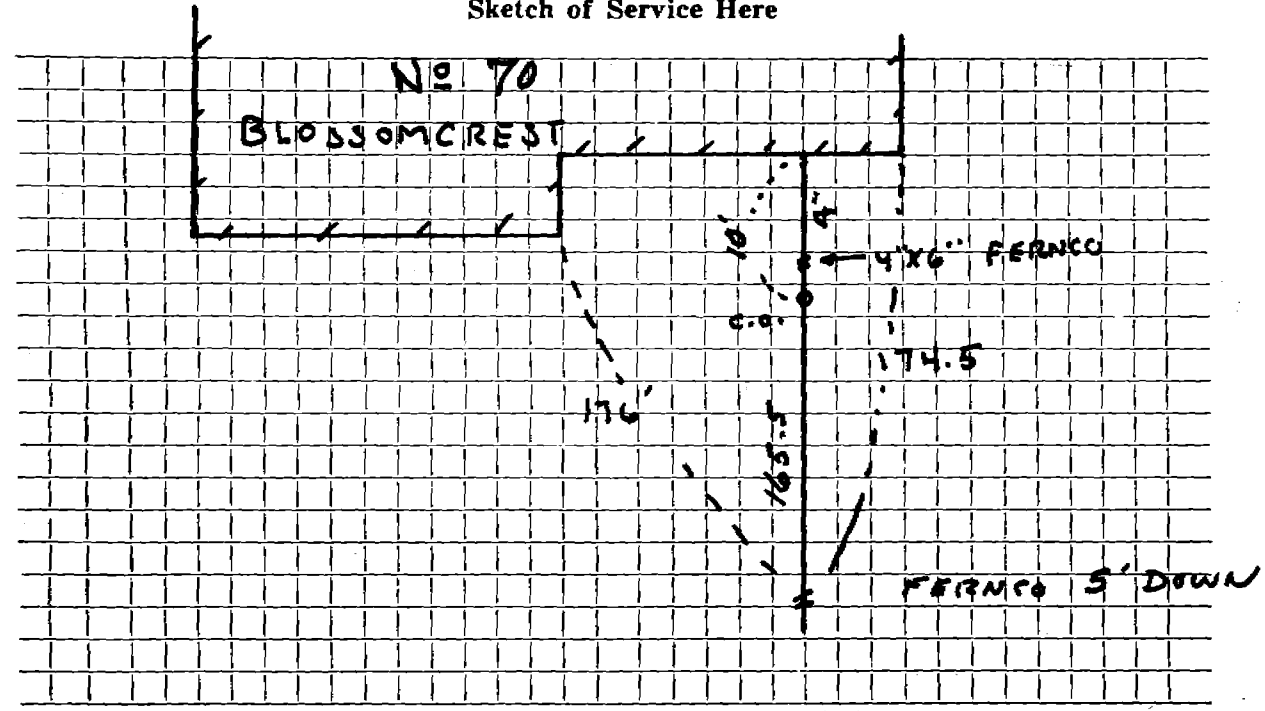

Connection made in BLOSSOMCREST..... Street. Work completed CIMINA CONST......

Remarks:

..... FIELD BOOK 97-5 T.M.