

Name

Service No.

Address 74 Blossomcrest Road

74 Blossomcrest Rd

Location

Kind of Pipe

Size

Size of Main

Repair—Renewal—New Service

Location

Date

Material

Amount

Total

Date

Amount

1967

28' 6" Transite pipe @7.00

196.00

Inside 10-8-98 121'-6" PVC

6x6 AC to PVC FEMALE

6x4 PVC to PVC FEMALE

6x6x6 PVC WYE


2-45° BENDS

28' 6" Transite @7.00

DATE \_\_\_\_\_

TOWN OF LEXINGTON — BOARD OF PUBLIC WORKS  
SEWER DIVISION

Sketch of Service Here **74**

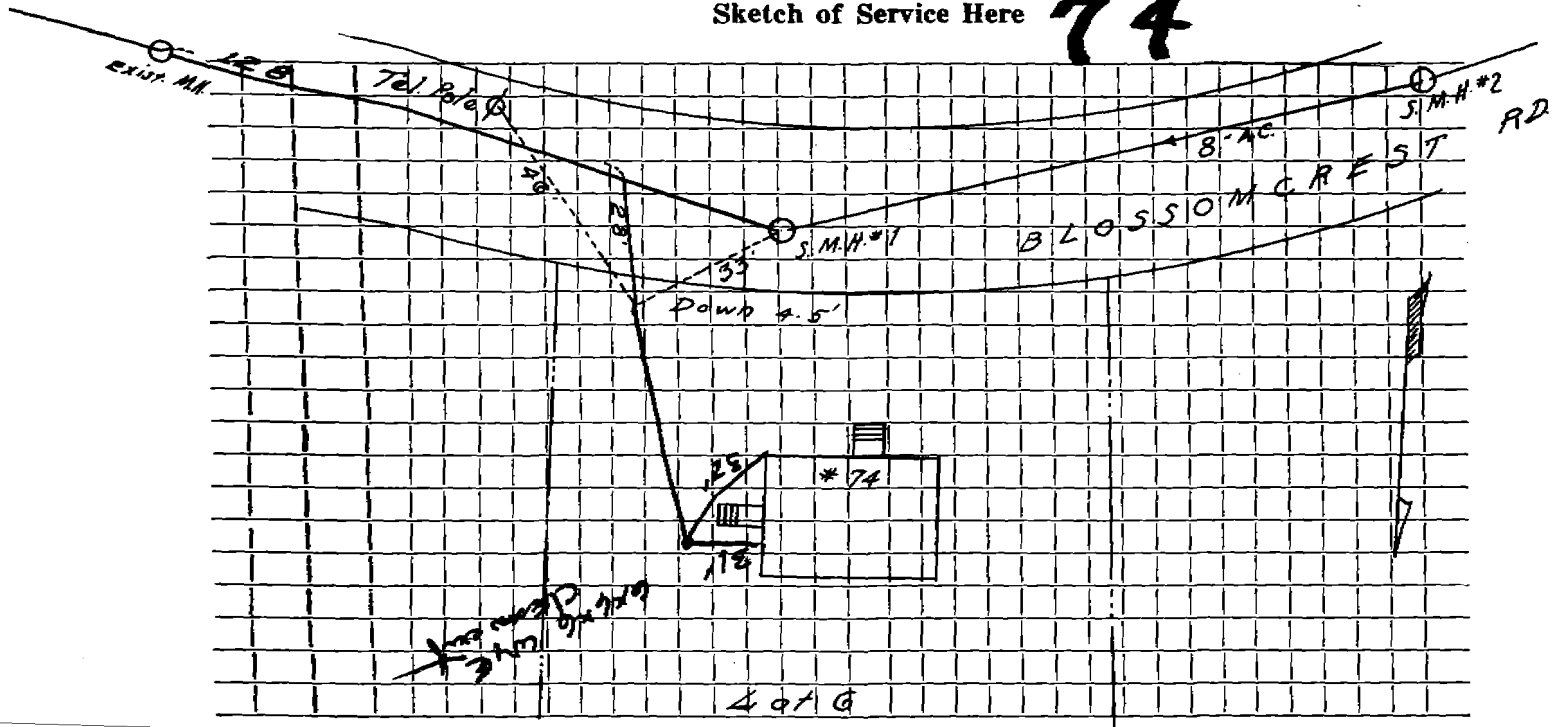

Connection made in ..... Street. Work completed .....

Remarks: .....  
.....  
.....