

Name Robert Phelan

Service No. 7

Address 75 Blossomcrest Road

Lot 25 Blossomcrest Rd

Lot #25

Location

Kind of Pipe

Size

Size of Main

Repair—Renewal—New Service W.O. #5765 Redmond #4270


Location SEP 5 1986

Date	Material	Amount	Total	Date	Amount
1967 20'	6" Transite pipe @ 7.00		140.00	4-14-86	333 65
	SERVICE EXTENDED				
11/13/67	Labor	33 50			
	10% O.H.	3 35	38 85		
10'	6" transite pipe @ .88		8 80		
1	Hr. Shovel		6 50		
1/2	Hr. Trucking @ 3.00		1 50		
	BILL WHEN CONNECTED		193 65		
6/4/86 91'	6" P.V.C.		333 65		
10'	4" P.V.C.				
1	6" x 22 1/2° Elbow				
1	6" ACP x PVC Adaptor				
1	6" x 4" Adaptor				

DATE Nov/1967

TOWN OF LEXINGTON — BOARD OF PUBLIC WORKS
SEWER DIVISION

Sketch of Service Here **75**

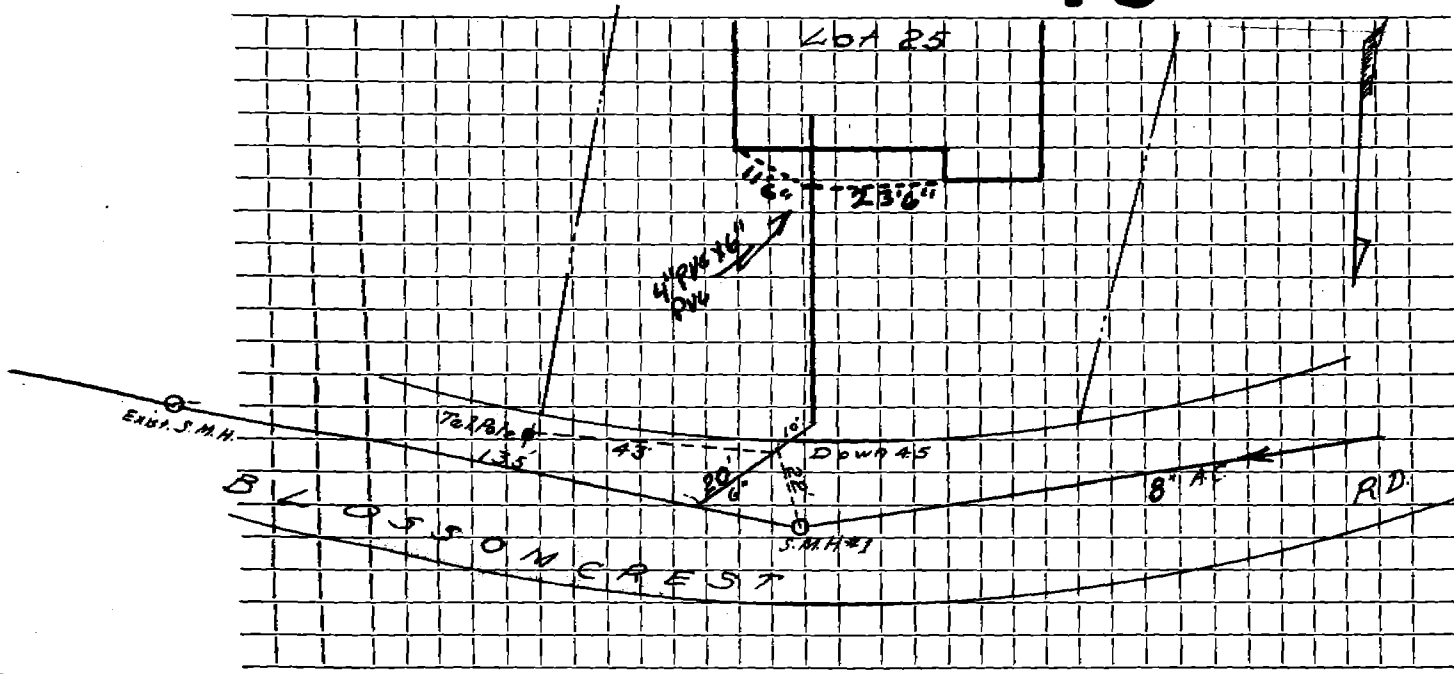

Connection made in BLOSSOMCREST RD Street. Work completed JUNE 1968

Remarks: