


DATE 9-26-01

TOWN OF LEXINGTON — BOARD OF PUBLIC WORKS
SEWER DIVISION

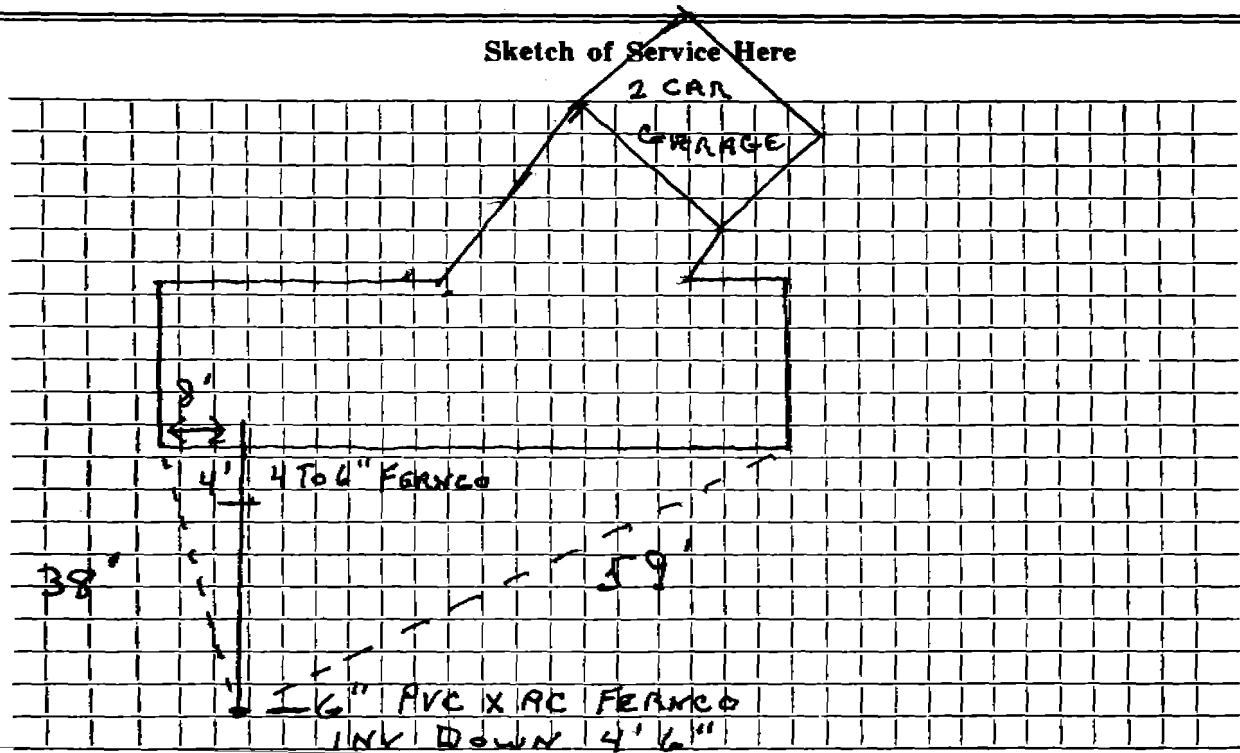

Connection made in BLOSSOMCREST Street. Work completed

Remarks: INSTALLED BY J. McLAUGHLIN

.....
.....