

Name Francis McCarron

Service No. 31

1977

Address 95 Blossom Street

JUN 2 1977

Location

Kind of Pipe

Size

Size of Main

~~Repair~~ New Service W.O. #2681

DeFlice Bros. #3289

Location

| Date | Material | Amount | Total | Date | Amount |
|---------|-------------------------------|--------|--------|---------|------------------|
| 6-29-66 | Labor <i>Outside</i> | 64 00 | | 5/26/77 | Deposit |
| | 10% O.H. | 6 40 | 70 40 | | 138. 5 |
| 30' | 6" Transite pipe @ .88 | | 24 00 | 5-27-77 | Inside |
| 1 | 6" Elbow | | 4 09 | | 46' 6" Transite |
| 8 1/4 | Ton Gravel @ 1.40 | | 11 55 | | 10' 4" Cast Iron |
| 3 | Hrs. Trucking @ 3.00 | | 9 00 | | |
| 3 | Hrs. Shovel @ 6.50 | | 19 50 | | |
| | | | 138 54 | | |
| | (TO BE BILLED WHEN CONNECTED) | | | | |


DATE _____

TOWN OF LEXINGTON — BOARD OF PUBLIC WORKS

SEWER DIVISION

Sketch of Service Here

95

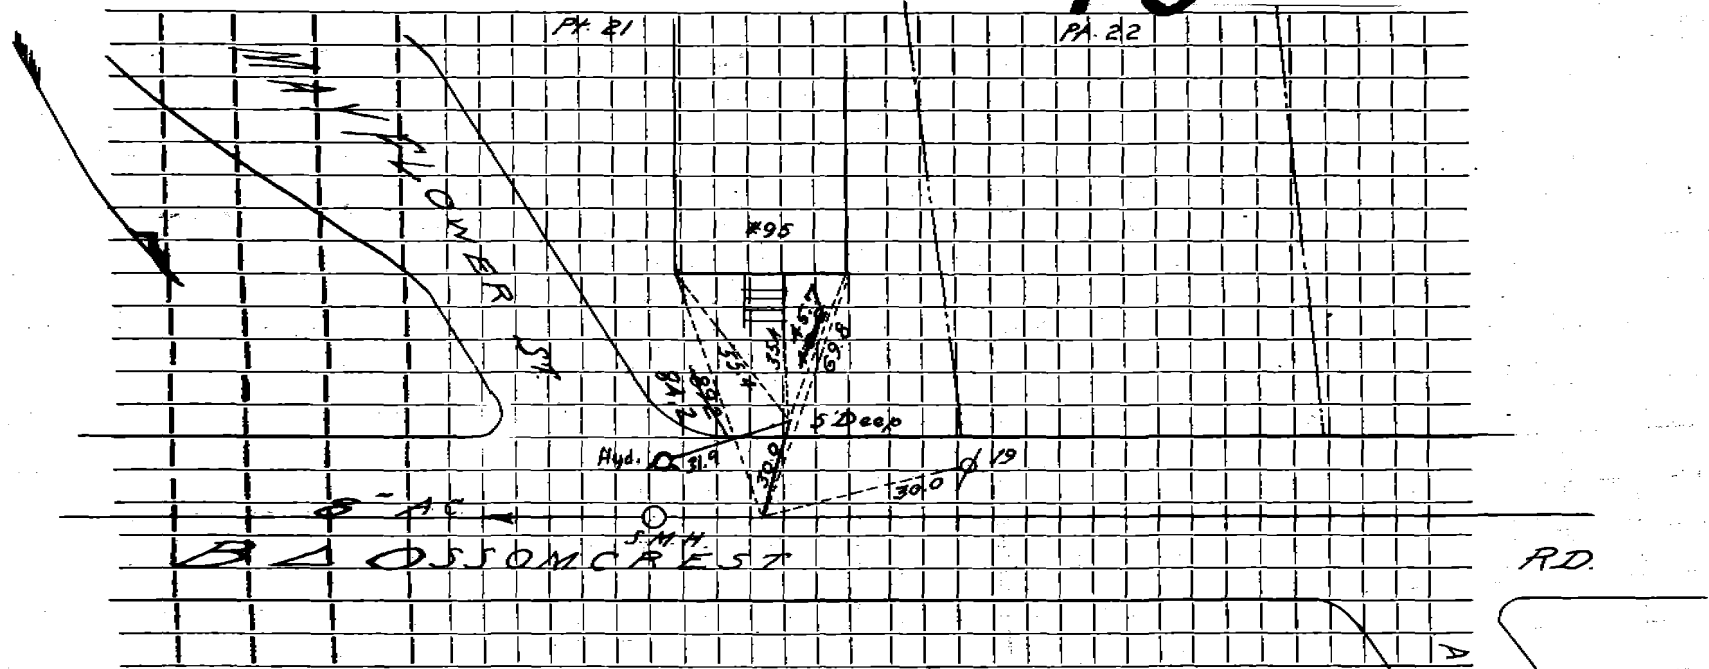

Connection made in Street. Work completed

marks:

.....

