

Name Busa Realty Trust

Service No. 13

Address 97 Blossomcrest Road

Location

Kind of Pipe

Size

Size of Main

Repair Renewal New Service

Office #2032  
W. O. # 8460

Location JUN 5 1972

Date	Material	Amount	Total	Date	Amount
3/27/72	Labor	124 80		3-2-72	Deposit 300 00
4/14/72	"	24 82		4-5-72	Paid by WIK #5 38 49
	10% O.H.	14 96	164 58	8-24-72	Paid 26 59
	10' 6" Transite pipe .90		9 00		265 08
	1 C.I. 6"x8" Saddle		15 95		
	1 30" Sweep		8 67		
	1 6" Cap		2 55		
	1 Ton cold patch		8 00		
	1 Load gravel		14 00		
	2 Ton 3/4" stone 1.75		3 50		
	1 1/2 Ton hot top 7.45		11 08		
	5 1/2 Hrs. Trucking 3.00		16 50		
	1 Hr. Compressor		5 00		
	1 1/2 Hr. Shovel 6.50		3 25		
	1/2 Hr. Roller 2.00		1 00		
	Trailer		2 00		
			265 08		
3/27/72	27' 6" Transite pipe				
	10' 4" Cast Iron pipe				
					Bill Scot 26.59


DATE \_\_\_\_\_

TOWN OF LEXINGTON — BOARD OF PUBLIC WORKS

SEWER DIVISION

Sketch of Service Here

97

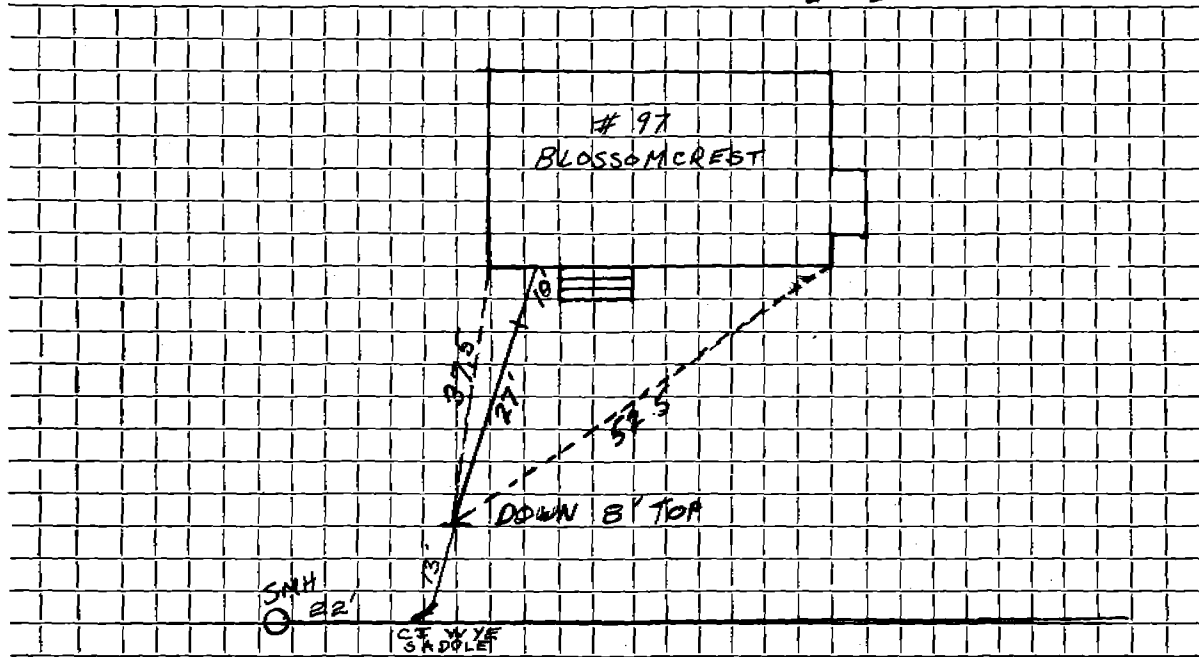

Connection made in ..... J. Street.

Work completed .....

Remarks: .....

.....

.....