

Name Donald Leone

Service No. 157

Address 98 Blossomcrest Road

Location

Kind of Pipe

Size

Size of Main

~~REPAIR WORK~~—New Service W.O. #3869 DePolice #2934

Location MAR 15 1976

Date	Material	Amount	Total	Date	Amount
12/10/75	Labor	183.98		11-9-75	300.00
	10% O.H.	18.40	202.38	8-21-76	186.59
	20' 6" Transite pipe @1.48		29.60		406.59
	1 6" x 8" C.I. Saddle		14.70		
	2 1' x 6" Nipple @ 2.44		4.88		
	1 90° Elbow		5.48		
	1 5' x 6" Nipple @1.56		7.80		
	1 6" Cap		3.75		
	Patch 7' x 24'		114.00		
	3 hrs. Trucking @3.00		9.00		
	2 hrs. Town Shovel @6.50		13.00		
	½ hr. Loader @4.00		2.00		
			406.59		
12/17/75	50' 6" Transite pipe				
	6' 4" C. I. Pipe				

DATE _____


TOWN OF LEXINGTON — BOARD OF PUBLIC WORKS
SEWER DIVISION

Sketch of Service Here

98

98

Blossom Crest
Road

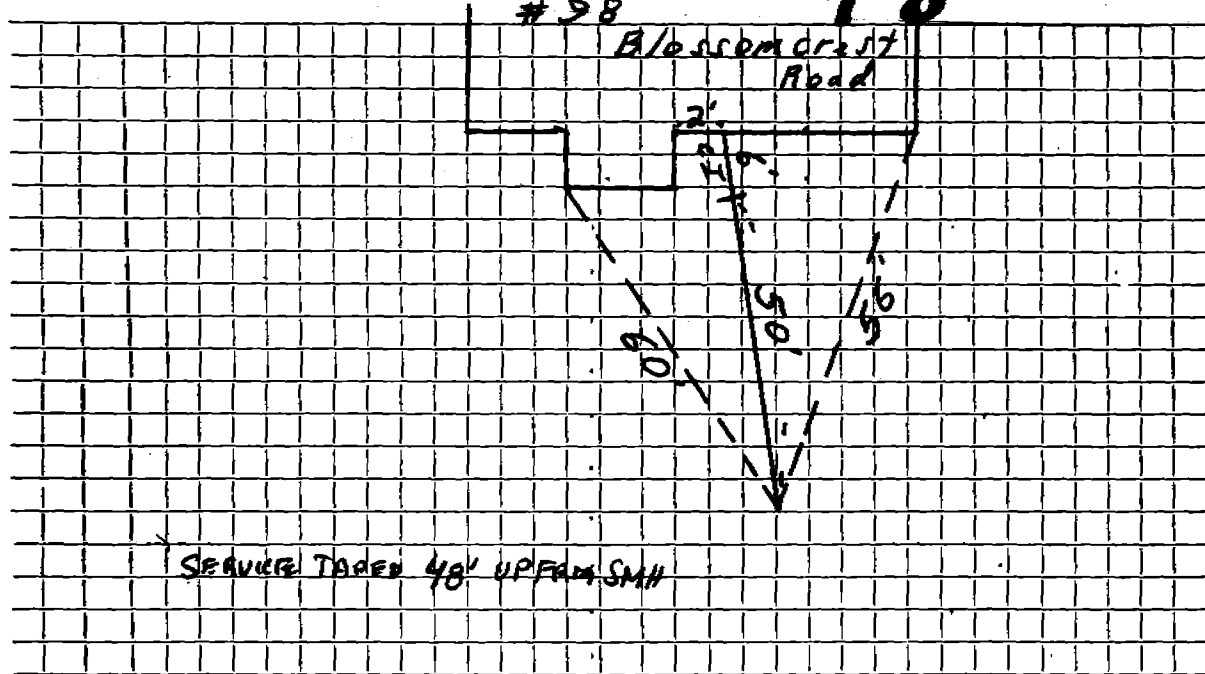

SERVICE TAPED 48' UP FROM SMH

Connection made in Street. Work completed

Remarks:

.....

.....