

Name Busa Realty Trust

Service No. 14

Address 99 Blossomcrest Road

Location

Kind of Pipe

Size

Size of Main

~~Repaired~~ New Service

Office #2033  
W. O. # 8462


Location JUN 5 1972

Date	Material	Amount	Total	Date	Amount
3/27/72	Labor	115 53		5-2-72	Deposit 300 00
4/14/72	"	24 83	140 36	6-5-72	Paid by W.H.C.#6 36 91
	10% O.H.	14 04	154 40	8-24-72	Paid 18 71
	10' 6" Transite pipe .90		9 00		255 62
	1 8"x6" C.I.' Saddle		15 95		
	1 30o Sweep		8 67		
	1 11/2o Sweep		4 65		
	1 6'x3' Nipple		4 00		
	1 6"x5' Nipple		5 00		
	1 6" Cap		2 55		
	2 Ton cold patch 8.00		16 00		
	2 Ton hot top 7.45		14 90		
	5 Hrs. Trucking 3.00		15 00		
	1/2 Hr. Compressor 5.00		2 50		
	1/2 Hr. Roller 2.00		1 00		
	Trailer		2 00		
			255 62		
4-15-72	26' 6" Transite pipe				
	10' 4" Cast Iron pipe				
					Bill 5207 18 71

DATE \_\_\_\_\_

TOWN OF LEXINGTON — BOARD OF PUBLIC WORKS  
SEWER DIVISION

Sketch of Service Here **99**

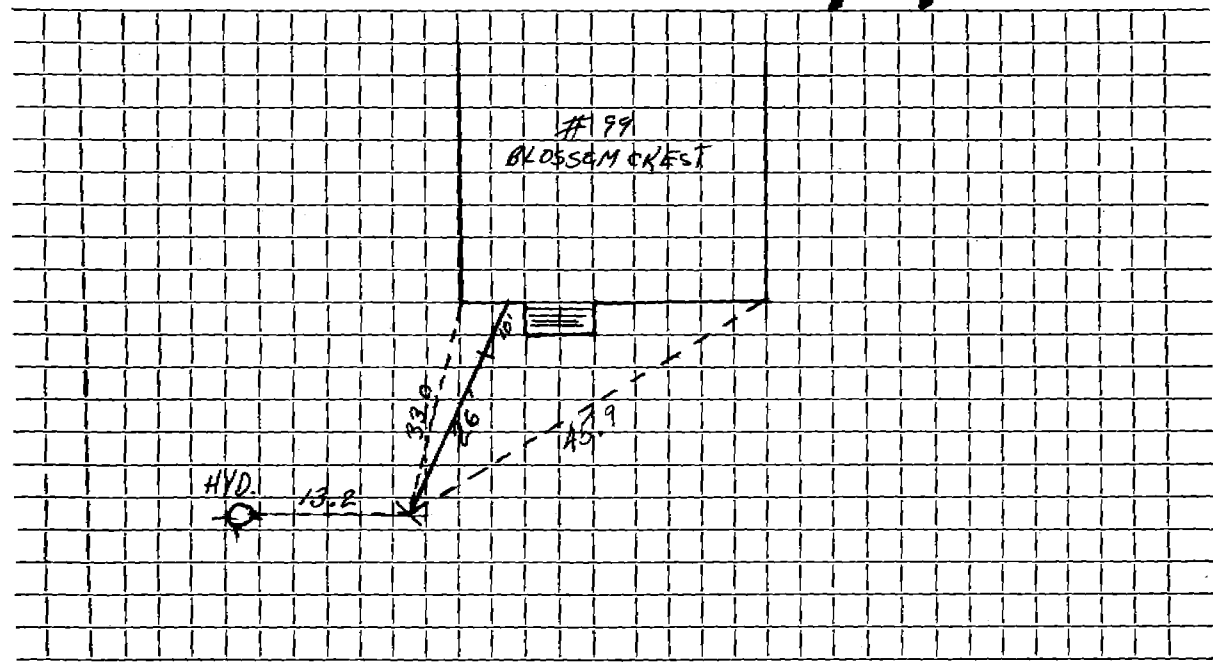

Connection made in ..... Street. Work completed .....

Remarks: .....  
.....  
.....