

Name

Service No.

Address

7 BLUEBERRY LANE

Location

LEXINGTON, MA

Kind of Pipe

SDR35 PVC

Size

6"

Size of Main

Repair

~~Renewal~~

New Service

Location

Date

Material

Amount

Total

Date

Amount

5/6/22

6" CLEANOUT


6" FERRULE

6" SDR35 PVC

DATE 5/6/22

TOWN OF LEXINGTON — BOARD OF PUBLIC WORKS
SEWER DIVISION

Sketch of Service Here

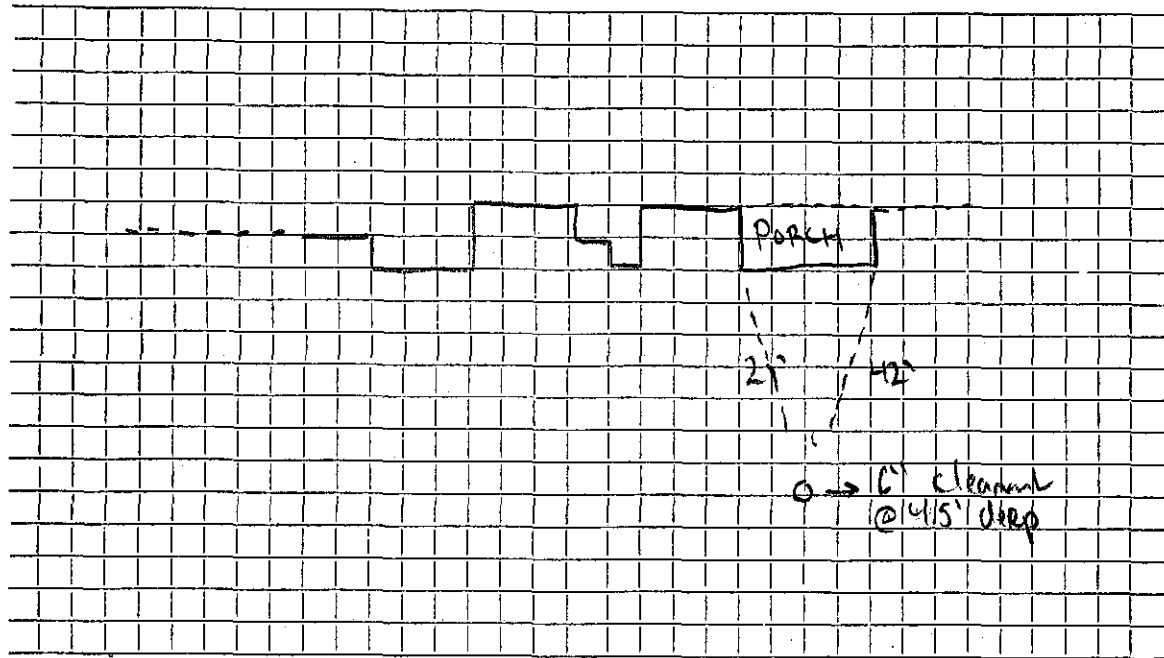

Connection made in Street. Work completed

Remarks: INSTALLED BY MCLAUGHLIN
SEWER REPLACED TO THE MAIN