


PIPE 10

DATE _____

TOWN OF LEXINGTON — BOARD OF PUBLIC WORKS SEWER DIVISION

#3 Bend Road

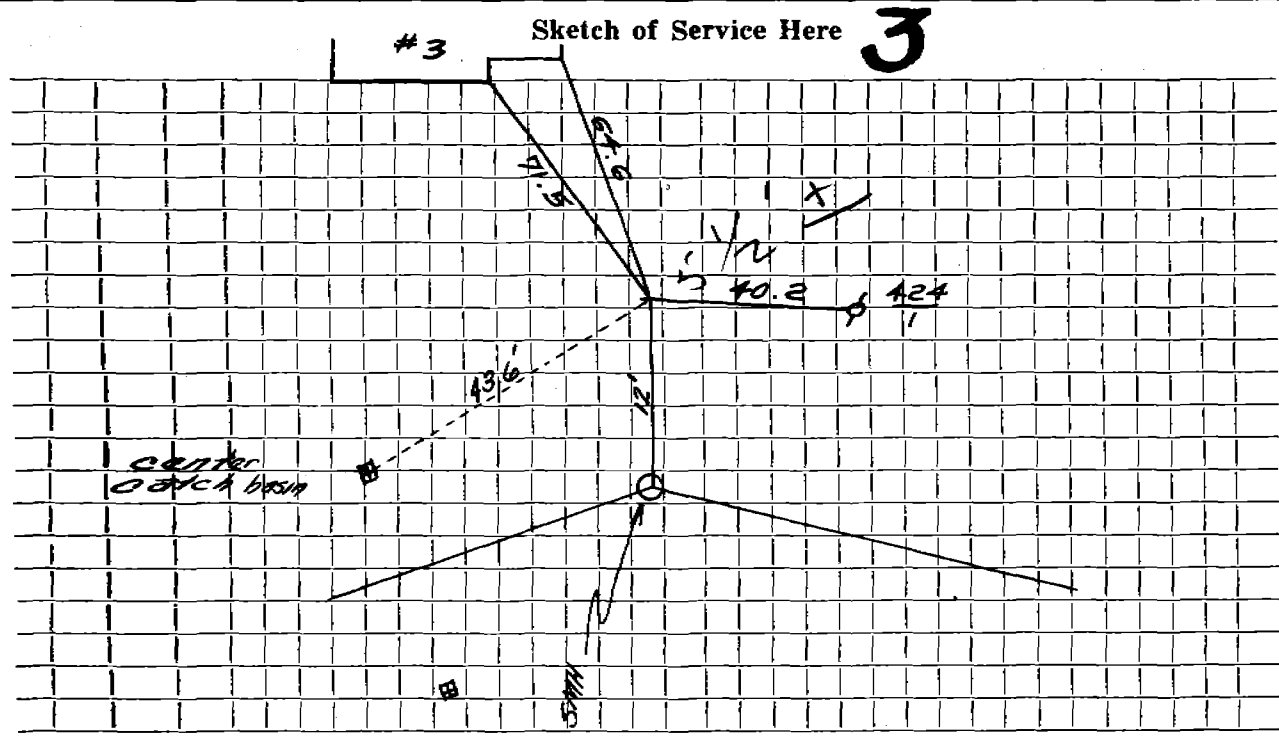

Connection made in Street. Work completed

Remarks:
.....
.....