

Name Athena Kutrubes

Service No. 85

Address 4 Bond Road

Lot 16 Sta. 2+81 Elev. 199.22

Location

Kind of Pipe Lexington Landscaping Permit #366 Size

Size of Main

~~REPAIR/RENEWAL~~ - New Service

Location


SEP 27 1965

Date	Material	Amount	Total	Date	Amount
8-10-62	38' 6" Transite pipe @.82		31.16	6-28-65	31.16
	BILL WHEN CONNECTED				
1965	34' 6" Transite pipe				
	REPAIR * W.O.#1923				
3-3-66	Labor 130.51				
4-7-66	Labor 32.60				
4-8-66	Labor 23.30	186.41			
	10% O.H.	18.64	205.05		
	5' 6" Transite pipe @.82		4.10		
	8½ Ton-1½ stone @ 1.65		14.02		
	36½ Ton Gravel @ 1.10		38.87		
	8 x 3 Patch		8.00		
	9 Hrs. Trucking @ 3.00		27.00		
	4 Hrs. Shovel @ 6.50		26.00	1 Hr. Trailer	2.00
	4 Hrs. Pump @ 1.00		4.00	½ Hr. Roller @ 3.00	1.50

DATE _____

TOWN OF LEXINGTON — BOARD OF PUBLIC WORKS
SEWER DIVISION

Sketch of Service Here **4**

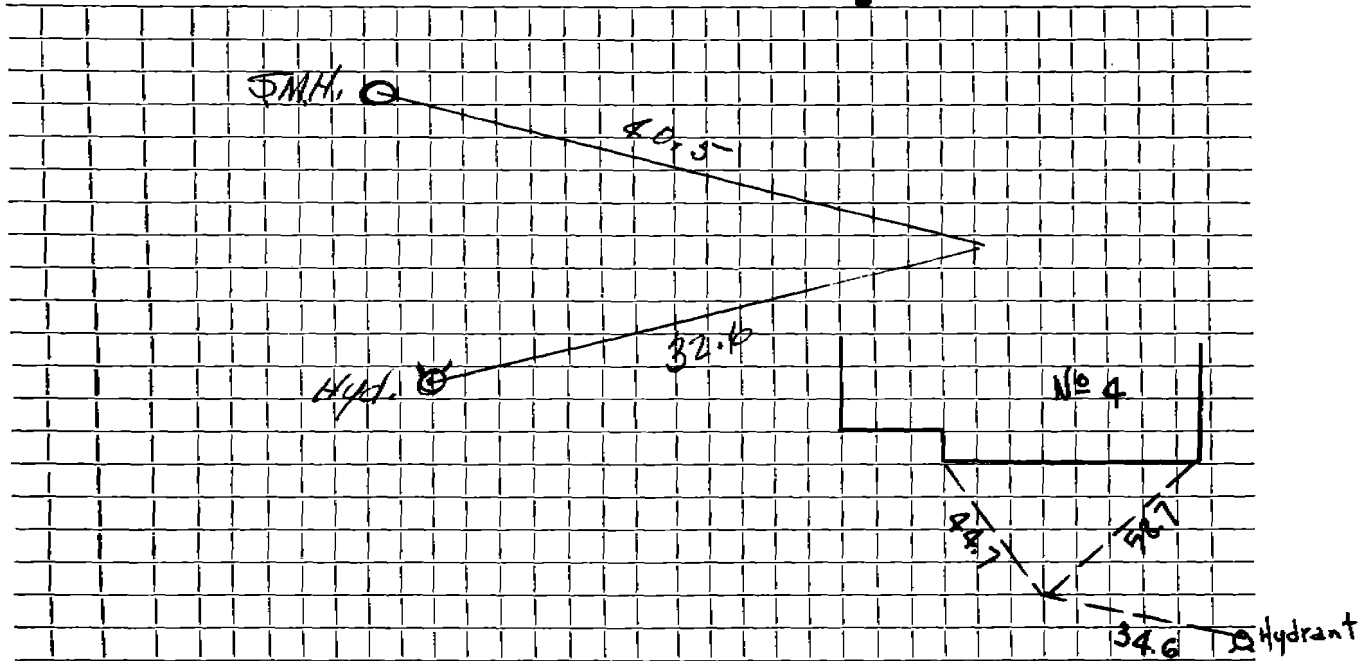

Connection made in Street. Work completed

Remarks:
.....
.....