

Name Edgewood Construction, Inc.

Service No. 75

Address 7 1/2 Bond Road

Lot 15 Sta. 2+58 Elev. 199.22

Location

Kind of Pipe Kirkland & Shaw Permit #381

Size

Size of Main

~~REPAIR~~—New Service

Location


SEP 27 1965

Date	Material	Amount	Total	Date	Amount
8-10-62	38' 6" Transite pipe @.82		31.16	7-8-65	Deposit
	BILL WHEN CONNECTED				.31 16
7-8-65	34' 6" Transite pipe				

DATE \_\_\_\_\_

**TOWN OF LEXINGTON — BOARD OF PUBLIC WORKS**  
**SEWER DIVISION**

Sketch of Service Here **7**

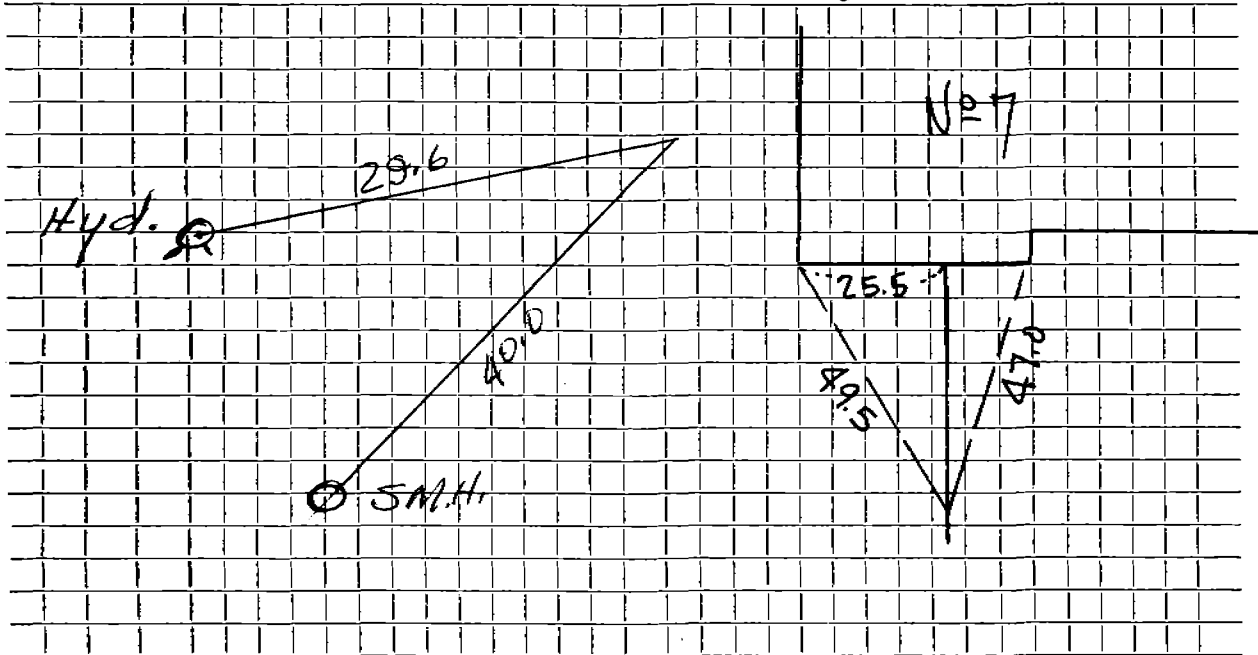

Connection made in ..... Street. Work completed .....

Remarks: .....  
.....  
.....