

Name

Service No.

Address 10 BOULDER RD.

Location

Kind of Pipe

Size

Size of Main

Repair—Renewal—New Service

Location

Date

Material

Amount

Total

Date

Amount

11-6-57

~~75' 6" V.C. Pipe~~

36' 6" TRANSITE

4' 6" Clay Pipe

2 6" ELBOW

1 6" TRANSITE ADAPTER


11-6-57

15' 6" V.C. PIPE

DATE _____

TOWN OF LEXINGTON — BOARD OF PUBLIC WORKS
SEWER DIVISION

Sketch of Service Here **10**

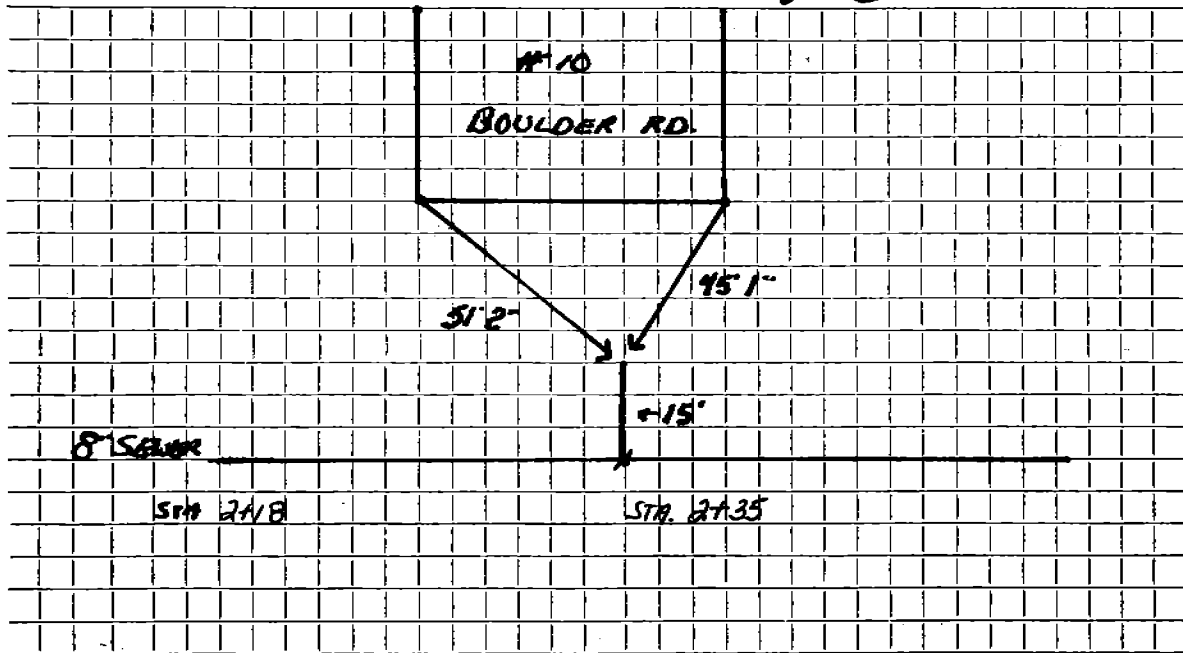

Connection made in Street. Work completed

Remarks:
.....
.....