

Name Mrs. Robert Siegfried

Service No. 7

Address 15 Boulder Road

Location

Kind of Pipe

Size

Size of Main

~~PIPE SERVICE~~ New Service

Location Comm 5-4-59

| Date | Material | Amount | Total | Date | Amount |
|--------|-------------------------------------|--------|--------|------------------|--------|
| | 32' 6" V.P. @3.00 | 96 00 | | 3-30-59 | 156 00 |
| | Installed by contractor | | | 6-22-59 | 70 40 |
| | (Bill owner when connected) | | | | 220 40 |
| 4-1-59 | Labor | 65 06 | | | |
| | 10% O. H. | 6 51 | 71 57 | | |
| | 23' 6" Transite Pipe @.70 | | 16. 10 | | |
| | 1 11 $\frac{1}{2}$ $^{\circ}$ Bend | | 5 10 | | |
| | 1 22 $\frac{1}{2}$ $^{\circ}$ Elbow | | 2 24 | | |
| | 1 1/8 $^{\circ}$ Clay Bend | | 1 24 | | |
| | 1 6" Duplex Adapter | | 1 90 | | |
| | 3 Hrs. Town Shovel @6.50 | | 19 50 | | |
| | 1 Hr. Trucking @.75 | | 75 | | |
| | 1 Labor Hr. Rodgers Trailer @3.00 | 3 00 | | | |
| | 1 Hr. Trucking @3.00 | | 3. 00 | | |
| | | | 124 40 | | |
| | Previous Charge | | 96 00 | Bill sent 5-4-59 | 70.40 |
| | | | 220 40 | | |

TOWN OF LEXINGTON—DEPT. OF PUBLIC WORKS
SEWER DIVISION

DATE. *June. 19. 57.*.....

NO.

The undersigned applies for the construction of a particular sewer connecting No.
Street and hereby agrees to comply with the Rules and Regulations governing the construction and use of Particular
Sewers, as now or at any future time established by the Board of Selectmen.


Am't of estimate \$.....

Am't Paid \$.....

..... Owner

Sketch of Service Here

15

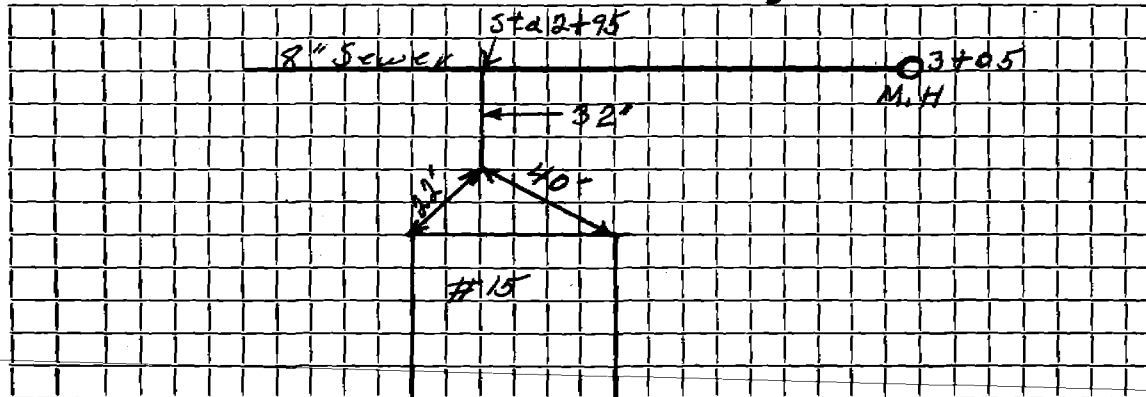

Connection made in Street.

Work completed.....19..

Remarks: