

Name Terass R. Jacobson

Service No. 72

Address 17 BOULDER RD.

Location

Kind of Pipe AC

Size 6"

Size of Main 8"

~~REPLACEMENT~~ New Service Engle #3446

Location DEC 3 1979


Date		Material	Amount	Total	Date	Amount	
8-24-	79	15' 6" AC @	\$17.00 =	255.00	10-12-79	Deposit	255.00
10-25-	79	15' 6" Transite pipe					
		18' 4" Cast Iron pipe					

DATE _____

TOWN OF LEXINGTON — BOARD OF PUBLIC WORKS
SEWER DIVISION

Sketch of Service Here

17

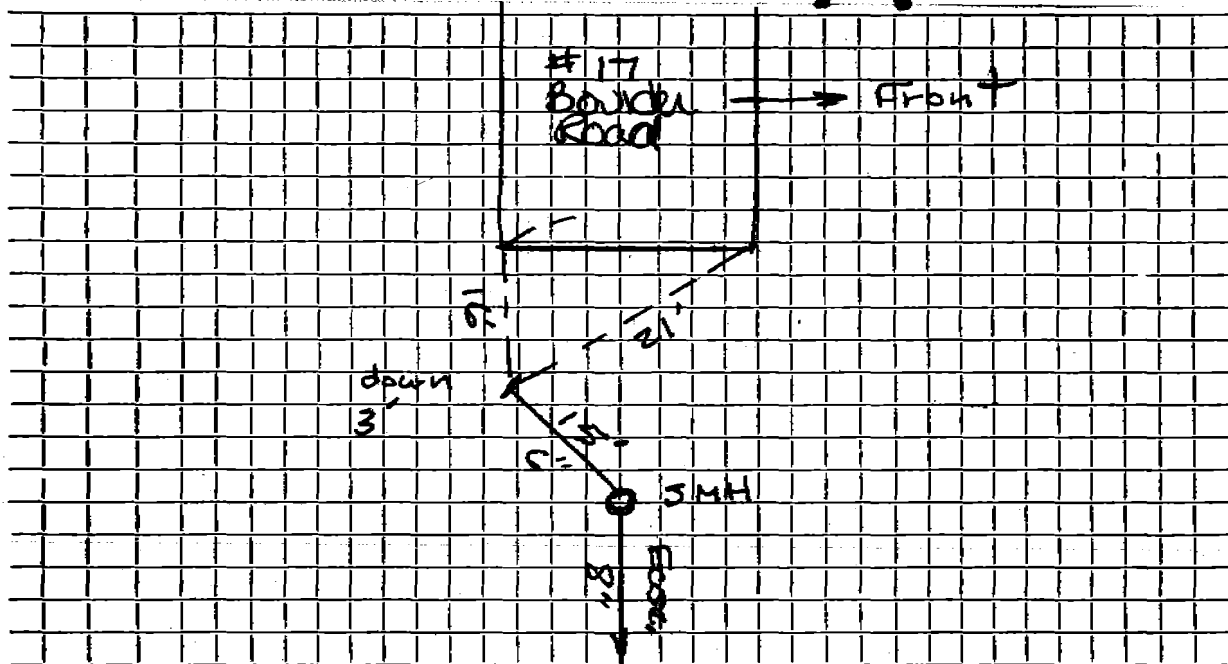

Connection made in Easement Street. Work completed

Remarks: Connection made to SMH

.....
.....