



DATE \_\_\_\_\_


# TOWN OF LEXINGTON — BOARD OF PUBLIC WORKS

## SEWER DIVISION

Sketch of Service Here

18

Front

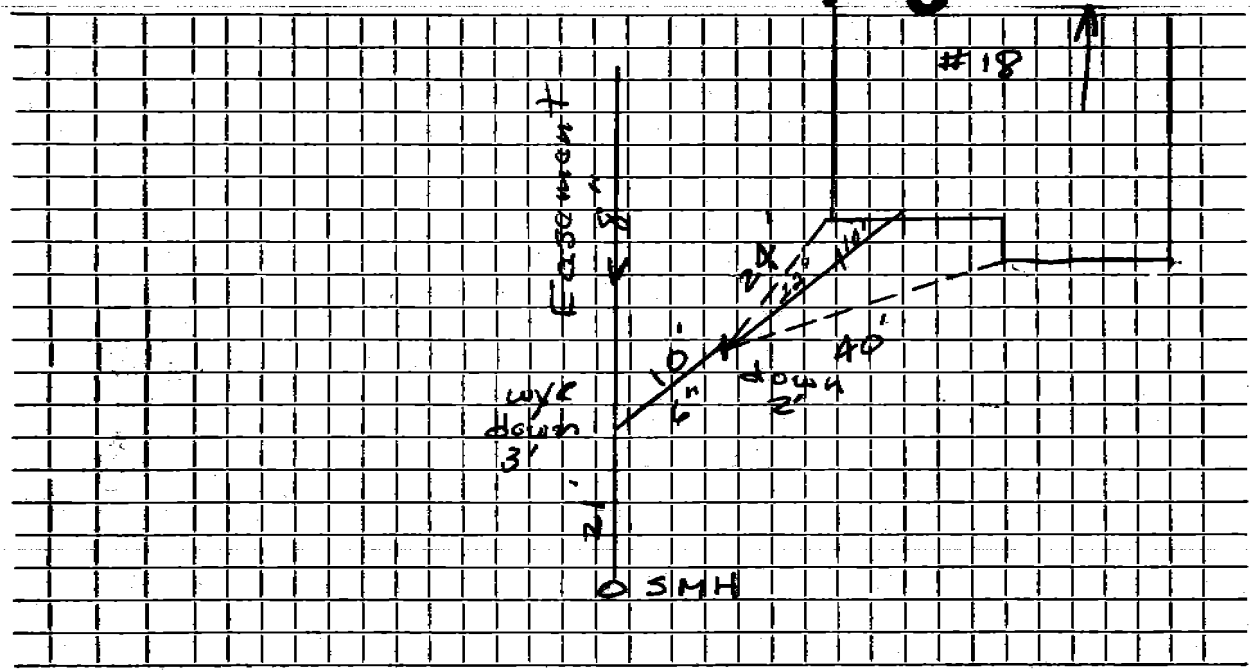

Connection made in Easement Street. Work completed .....

Remarks: .....