

Name

Service No.

Address

BOULDER ROAD

VACANT LOT

Location

lot E Boulder Road Md.

Kind of Pipe

Size

Size of Main

Repair—Renewal—New Service

Location

Date

Material

Amount

Total

Date

Amount

25' 6" V.C. @ 3.00 75.00

Installed by contractor

(Bill to owner when connected)

Labor

TOWN OF LEXINGTON—DEPT. OF PUBLIC WORKS

SEWER DIVISION

DATE... *June 1957*

NO.


The undersigned applies for the construction of a particular sewer connecting No.
 Street and hereby agrees to comply with the Rules and Regulations governing the construction and use of Particular
 Sewers, as now or at any future time established by the Board of Selectmen.

Am't of estimate \$.....

Am't Paid \$.....

..... Owner

Sketch of Service Here

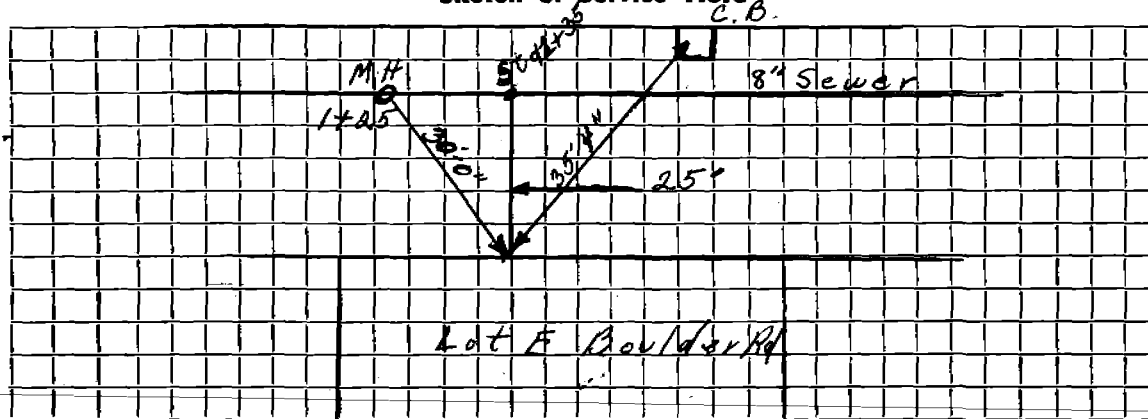

Connection made in Street.

Work completed 19..

Remarks: