

Name Antonio Busa
 Address 105 Bow Street

Service No. 1

Location

Kind of Pipe Size Size of Main

~~Repair/Replacement~~ New Service COM. 3-21-55 Location

Date	Material	Amount	Total	Date	Amount
2/24/55	Labor	19 87		1-10-55	100 00
	10% overhead	1 99	21 86	3-21-55	*Refunded (804)
	1/4" - 6" sewer pipe @ .32		14 08		91 96
	1 - 6" elbow		1 88		
	joint compound		2 64		
	4 2/3 hrs. Littlefield shovel @ 7.50		35 00		
	2 hrs. trucking @ .75		1 50		
	patching 15x3		15 00		
			91 96		
	Labor				

* This refund made payable to Town to apply on bal. due on S. H.C. #163 (1954)

**TOWN OF LEXINGTON—DEPT. OF PUBLIC WORKS
SEWER DIVISION**

DATE.....

NO.....


The undersigned applies for the construction of a particular sewer connecting No.....
Street and hereby agrees to comply with the Rules and Regulations governing the construction and use of Particular
Sewers, as now or at any future time established by the Board of Selectmen.

Am't of estimate \$.....

Am't Paid \$.....

..... Owner

Sketch of Service Here

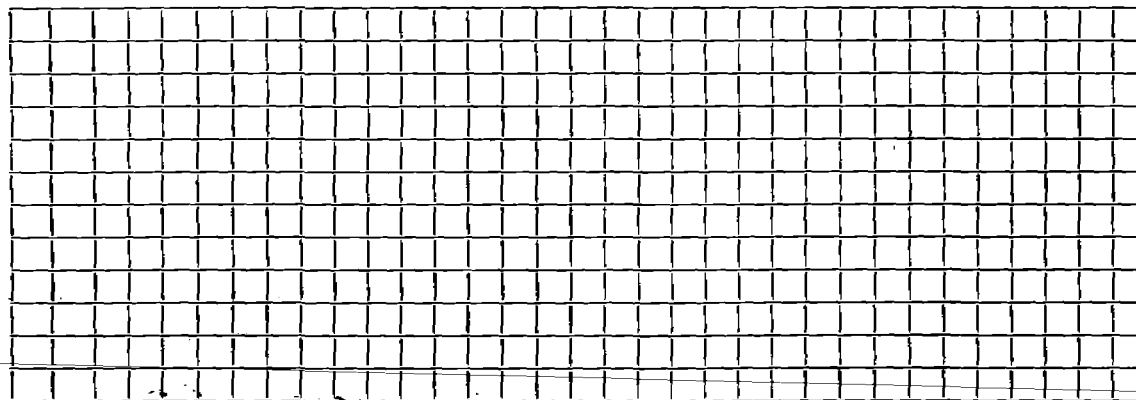

Connection made in Street.

Work completed.....19..

Remarks: