

Name **Carmine Massimilla**

Service No. **65**

Address **108-110 Bow Street**

Lexington, Mass.

Location **108-110 Bow Street**

Kind of Pipe

Size

Size of Main

~~EXPENSE ACCOUNT~~ **New Service**

Com. **11-14-49**

Location

Date	Material	Amount	Total	Date	Amount
Aug. 8, '49	Labor	55 27		Aug 2 49	100 00
Aug. 9, '49	Labor	13 00	68 27	Nov 17 49	6 65
	10% Overhead		6 83		93 35
	30' - 6" Sewer Pipe @.265		7 95		
	Joint Compound		1 80		
	Littlefield Shovel 1 hr. @ 7.00		7 00		
	Trucking 2 hrs. @.75		1 50		
			93 35		
	Labor				

TOWN OF LEXINGTON—DEPT. OF PUBLIC WORKS
SEWER DIVISION

DATE

NO.


The undersigned applies for the construction of a particular sewer connecting No.
Street and hereby agrees to comply with the Rules and Regulations governing the construction and use of Particular
Sewers, as now or at any future time established by the Board of Selectmen.

Am't of estimate \$

Am't Paid \$

..... Owner

Sketch of Service Here

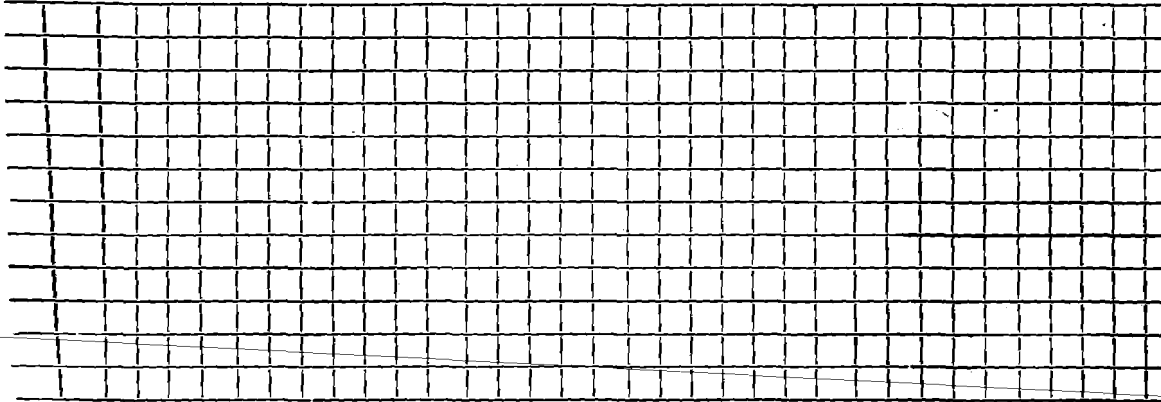

Connection made in Street.

Work completed 19..

Remarks: