

Name **Wiggins, John A.**

Service No. **102**

Address **1447 Mass. Ave., Arlington Hts., Mass.**

Location **28 Bow Street**

Kind of Pipe

Size

Size of Main

~~Refrigeration~~ - New Service

Location

| Date | Material | Amount | Total | Date | Amount |
|------------------------------------|-----------------------|--------|----------|----------------|------------------|
| 1936 Jan. | 175 hrs. labor @ 55¢ | 96 25 | | Jan. 1, 1936 | Deposited 105 00 |
| Com. 5123 1130.00 to Russell | 60' 6" S. Pipe @ 16¢ | 9 60 | | June 3, 1936 | " 15 00 |
| | Sulphur & Jute | 3 00 | | | |
| | Trucking | 75 | | | |
| | 3 hrs. Comp. @ \$3.50 | 10 50 | | | |
| | Dynamite & cap | 30 | | | |
| | | | \$120 40 | | |
| | | | | Billed 5/13/36 | |
| | Say: \$120.00 | | | | |
| | Labor | | | | |

Haley Press, Inc., Lexington

TOWN OF LEXINGTON, BOARD OF PUBLIC WORKS
SEWER DIVISION

DATE _____

NO. _____


The undersigned applies for the construction of a particular sewer connecting No. 28 Boy Street
~~Street~~ and hereby agrees to comply with the Rules and Regulations governing the construction and use of Particular
Sewers, as now or at any future time established by the Board of Selectmen.

Am't. of Estimate \$105.00

Am't. Paid \$ _____

John A. Higgins Owner

Please sign and return with deposit.

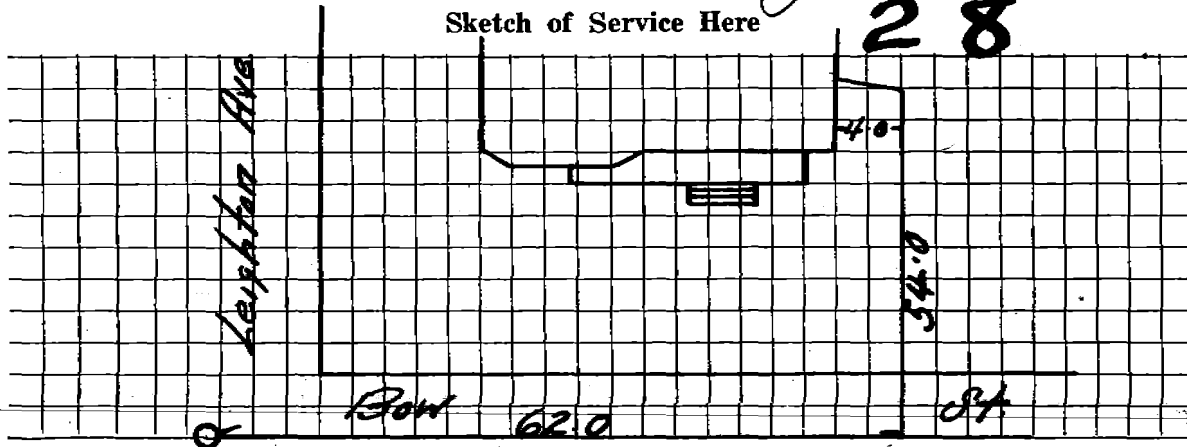

Connection made in _____ Street.

Work completed _____ 19

Remarks: