

Name *John James* Higgins

Service No. 4 103

Address 1447 Mass. Ave., Arlington

Location <sup>30</sup> Bow Street

Kind of Pipe Size Size of Main  
~~Repair - Renew~~ New Service Location

Date		Material	Amount	Total	Date		Amount
May 9	51	hrs. labor @ 55	28 05		1935 May 7	Cash	65 00
	11	" " @ 60	6 60	34 65	" 23	- Refunded	13 73
		10% Overhead on labor		3 47			51 27
	30	6" Sewer Pipe	6 00				
	2	1/8 Bends @ \$1.80	3 90				
		Sulphur & Jute	75				
	2	hrs. trucking @ 1.25	2 50	13 15			
				51 27			
		Labor					

Hudley Press, Inc., Lexington

TOWN OF LEXINGTON - BOARD OF PUBLIC WORKS

SEWER DIVISION

DATE April 27, 1935

NO. \_\_\_\_\_


The undersigned applies for the construction of a particular sewer connecting No. 30 Bow Street Street and hereby agrees to comply with the Rules and Regulations governing the construction and use of Particular Sewers, as now or at any future time established by the Board of Selectmen.

Am't. of Estimate \$ 65.00

Am't. Paid \$ \_\_\_\_\_

*John Wiggins*  
*1447 Mass. Ave., Arlington*

*Jimmie R. Higgins* Owner

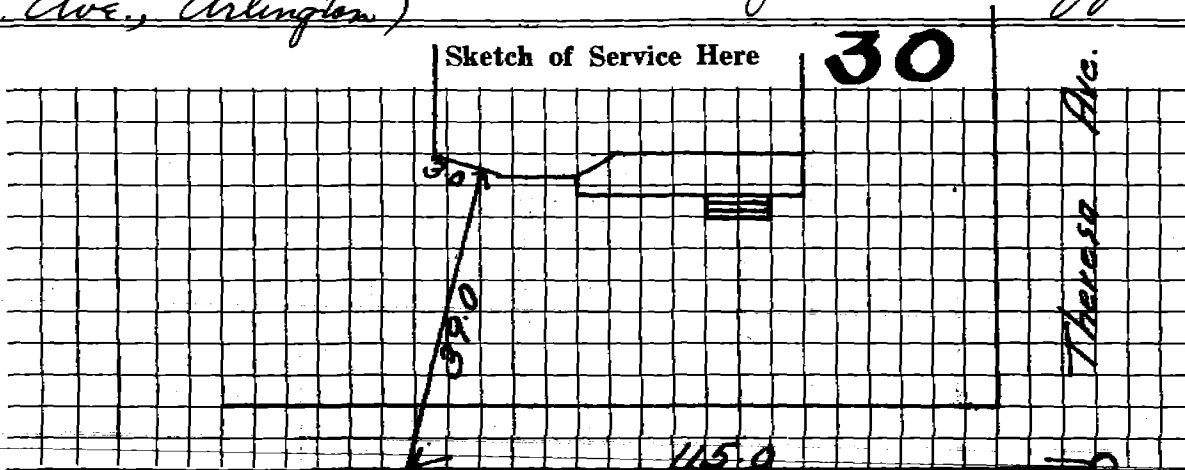

Connection made in \_\_\_\_\_

Bow Street.

Work completed St.

19

Remarks: