

Name Contractor: Eyecon Construction

Service No.

Address 34 Bow Street

Location

Kind of Pipe SDR 35 PVC

Size 6"

Size of Main

Repair ~~Renewal~~ New Service


Location

Date	Material	Amount	Total	Date	Amount
12/13/19	6" FernCo				
	6" PVC pipe				
	22° bend				
	6" PVC pipe				
	6" Cleanout w/ tee wye				
	6" PVC pipe				
	11° bend				
	6" PVC pipe				
	FernCo connect to exist. stub				
	cleanout depth = 4'6"				

DATE 12/13/18

TOWN OF LEXINGTON — BOARD OF PUBLIC WORKS
SEWER DIVISION

Sketch of Service Here

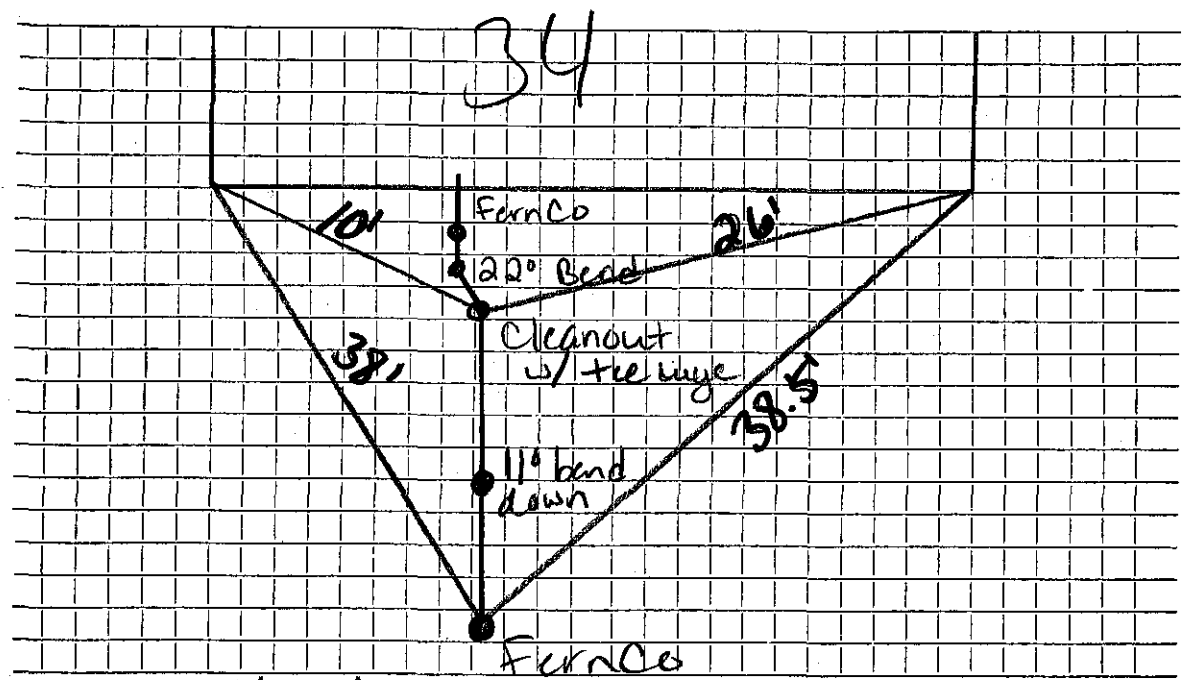

Connection made in Bow Street Street. Work completed

Remarks: After cleanout, sewer pipe drops at about a 45° angle then straightens out @ existing stub, but keeps standard slope