

Name

Service No.

Address 38 Bow ST.

Location

Kind of Pipe

Size

Size of Main

Repair—Renewal—New Service

Location

Date	Material	Amount	Total	Date			Amount
------	----------	--------	-------	------	--	--	--------

5-20-40

20' 6" Sewer Pipe

5-20-40

20' 6" Sewer Pipe


4-9-75 Sewer Block

DATE _____

TOWN OF LEXINGTON — BOARD OF PUBLIC WORKS
SEWER DIVISION

Sketch of Service Here

38

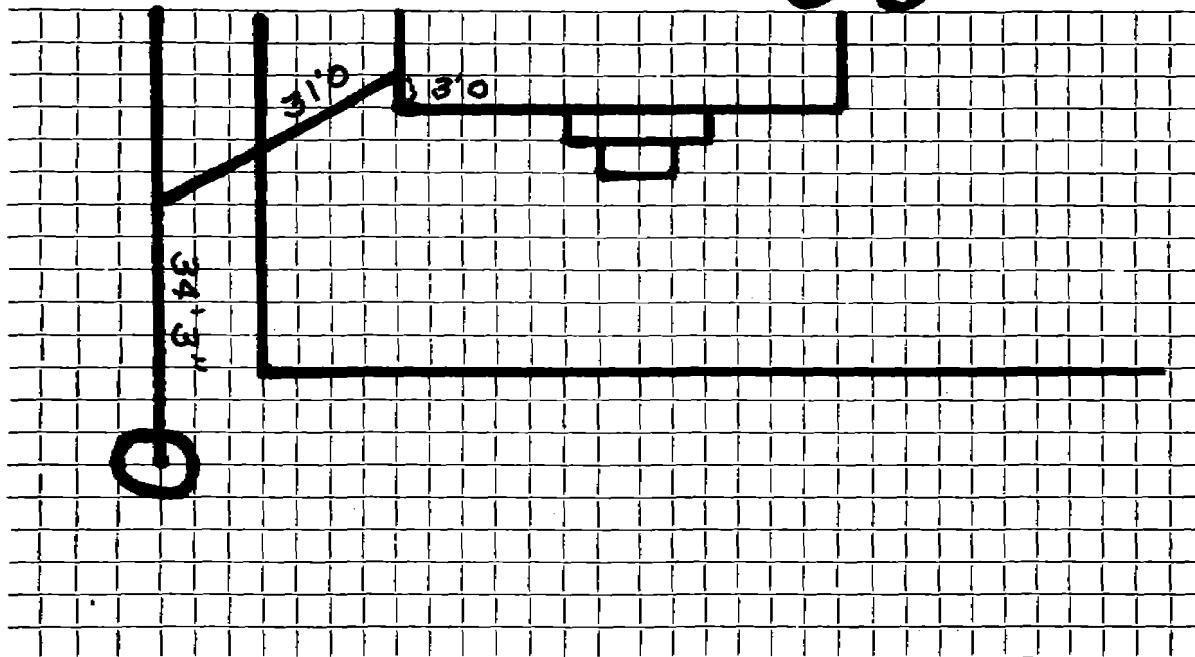

Connection made in Street. Work completed

Remarks:

.....