

Name Ralph Catald@

Service No. 89

Address 57 Bow Street

Location

Kind of Pipe

Size

Size of Main

~~Repair~~ Renewal ~~—~~ New Service W. O. # 9801

Location JUL 31 1972

Date		Material	Amount		Total	Date		Amount
6/22/72		Labor	102	42		6-15-72	Deposit	125 00
6/28/72		"	43	57	145 99	7-31-72	Paid by W/O # 89	32 95
	10%	O.H.			14 60	3-18-74	Paid	78 14
	10'	6" Transite pipe .90			9 00		NO CHARGE	274 09
	1	6" Cast Iron Saddle			15 95	6/22/72	Labor	45 52
	1	2'x6" Nipple			2 90			
	1	90o Elbow			5 65			
	1	5'x6" Pipe .89			4 45			
	1	6" Coupling			2 55			
	2	Ton Cold Patch 8.00			16 00			
	2	Ton Hot Top 8.00			16 00			
	3	Hrs. Trucking 3.00			9 00			
	1/2	" " 1.50			75			
	2 1/2	Hrs. Shovel 6.50			16 25			
	2	Hrs. Compressor 5.00			10 00			
	1	Hr. Loader			4 00			
	1/2	Hr. Roller 2.00			1 00			
		Trailer			2 00			
					276 09			
6/26/72	35'	6" Transite					Bill sent 78.14	
	10'	4" Cast Iron						


DATE \_\_\_\_\_

# TOWN OF LEXINGTON — BOARD OF PUBLIC WORKS

## SEWER DIVISION

Sketch of Service Here

**57**

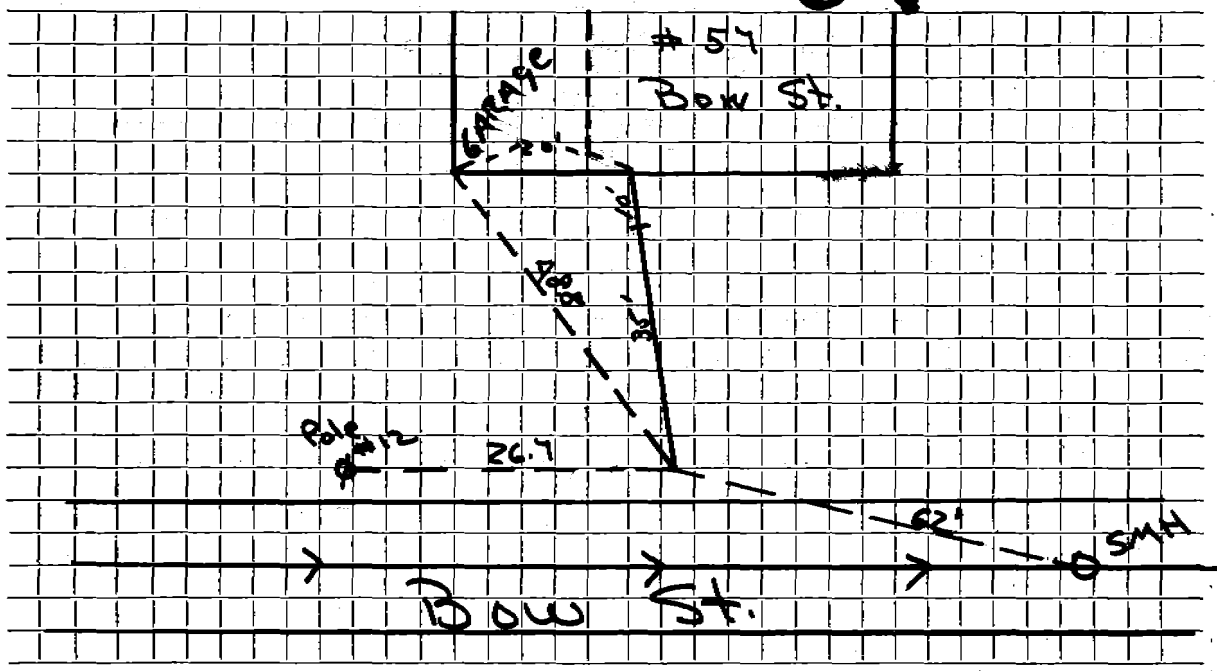

Connection made in ..... Street. Work completed .....

Remarks: .....  
.....  
.....