

Name Anthony Augustine

Service No. 29

Address ~~243 Bow Street~~ 71 Bow Street

AUG 21 1978

Location

Kind of Pipe

Size

Size of Main

~~NEW SERVICE~~ New Service Valeri #3070 W.O.#6421

Location


Date	Material	Amount	Total	Date	Amount
7-11-78	Labor	114.91		6-22-78	Deposit 200.00
	10% O.H.	11.49	126.40	8-21-78	Refund 36.77
20'	6" Transite @1.50		30.00		243.43
1	6 x 8 Saddle		22.29		NON CHARGE
1	6" Cap		4.12		Patch 24 x 7 111.96
1	6" x 6" Nipple		1.93		
1	90° Elbow		6.21		
24	Brick @.09		2.16		
1/2	bag cement.		1.62		
2	ton Cold Patch @14.75		29.50		
2	hrs. Trucking @3.00		6.00		
2	hrs. Backhoe @6.50		13.00		
	Hot Top 24 x 7		283.23		
7/12/78	71' 6" Transite pipe		355.19		
	10' 4" Cast iron pipe				

DATE _____

TOWN OF LEXINGTON — BOARD OF PUBLIC WORKS
SEWER DIVISION

Sketch of Service Here

71

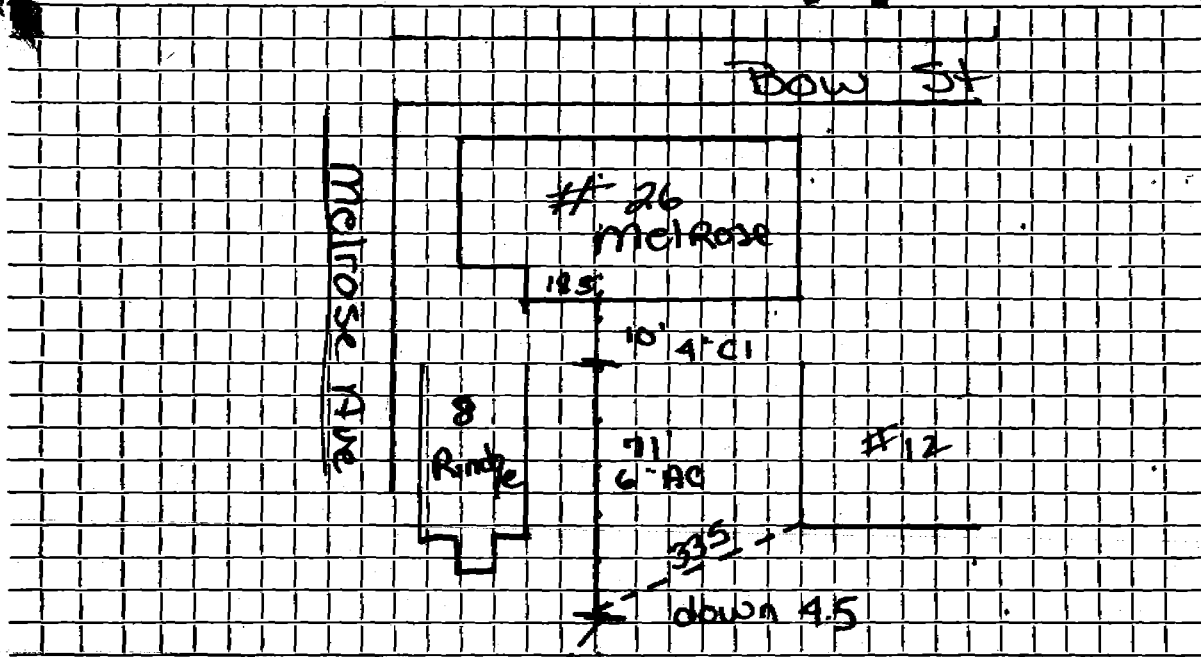

Connection made in Street 39' Work completed

Remarks: Ridge Ave

11