

Name Maria Santosuosso

Service No. 59

Address 83 Bow Street

Lexington, Mass.

Location 83 Bow Street

Kind of Pipe

Size

Size of Main

~~XXXXXX~~ New Service

Com. 11-14-49

Location

Date	Material	Amount	Total	Date	Amount
Jul. 28, '49	Labor	14 53	14 53	July 25 '49	60 00
	10% Overhead		1 45	Nov 17 '49	19 19
	18' - 6" Sewer Pipe @.265		4 77		40 33
	Joint Compound		1 08		
	Littlefield Shovel 2 hrs. @7.00		14 00		
	Hough Loader 1 hr. @ 3.00		3 00		
	Trucking 2 hrs. @.75		1 50		
			40 33		
	Labor				

**TOWN OF LEXINGTON—DEPT. OF PUBLIC WORKS
SEWER DIVISION**

DATE

NO.


The undersigned applies for the construction of a particular sewer connecting No. Street and hereby agrees to comply with the Rules and Regulations governing the construction and use of Particular Sewers, as now or at any future time established by the Board of Selectmen.

Am't of estimate \$.....

Am't Paid \$.....

..... Owner

Sketch of Service Here

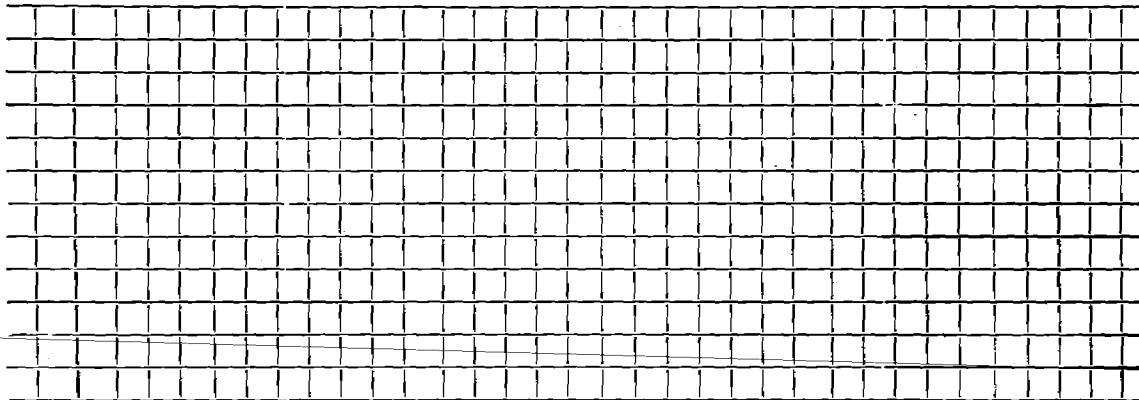

Connection made in Street.

Work completed 19..

Remarks: