

Name **Antonio Mongiello**  
 Address **92 Bow St., Lexington**

Service No. **187**

Location

Kind of Pipe

Size

Size of Main

~~Repair~~ ~~Renewal~~ — New Service

Location *Com. 11-21-55*

Date	Material	Amount	Total	Date	Amount
10/16/55	Labor	9 60		<i>9-12-55</i>	<i>Deposited 100 00</i>
	10% Overhead	96	10 56	<i>11-21-55</i>	<i>Refunded (48 59</i>
	20'-6" Sewer Pipe @.32		6 40		<i>51 41</i>
	Joint Compound		1 20		
	10 x 3 patching		10 00		
	3 hrs. Littlefield Shovel @7.50		22 50		
	1 hr. trucking @.75		75		
			51 41		
				<i>5-14-81</i>	<i>S.B. 32' out</i>
	Labor				

# TOWN OF LEXINGTON—DEPT. OF PUBLIC WORKS

## SEWER DIVISION

DATE .....

NO. ....

The undersigned applies for the construction of a particular sewer connecting No. ....  
Street and hereby agrees to comply with the Rules and Regulations governing the construction and use of Particular  
Sewers, as now or at any future time established by the Board of Selectmen.


Am't of estimate \$. .....

Am't Paid \$. .....

..... Owner

---

### Sketch of Service Here

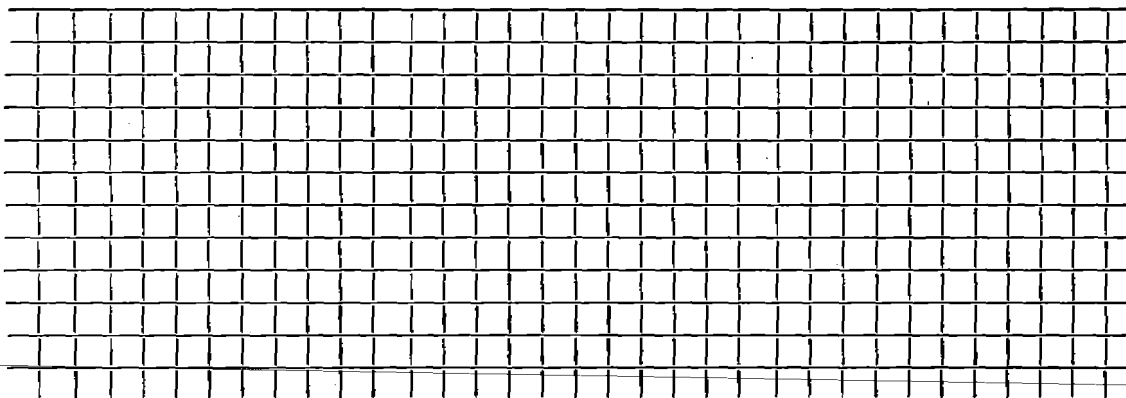

Connection made in ..... Street.

Work completed ..... 19..

Remarks: