


DATE DEC 19, 1984

TOWN OF LEXINGTON — BOARD OF PUBLIC WORKS
SEWER DIVISION

Sketch of Service Here

LOT # 3

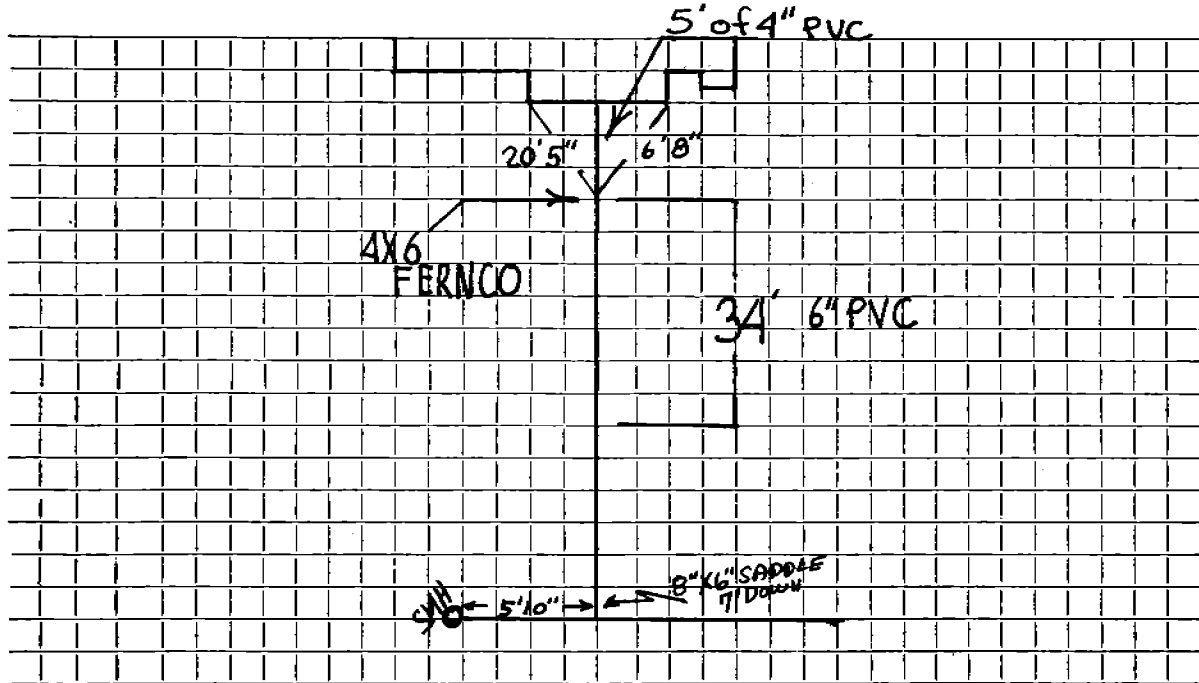

Connection made in Bow St Street. Work completed DEC 1984

Remarks: Original Service 1929