




DATE DEC 19, 1984

TOWN OF LEXINGTON — BOARD OF PUBLIC WORKS  
SEWER DIVISION

Sketch of Service Here

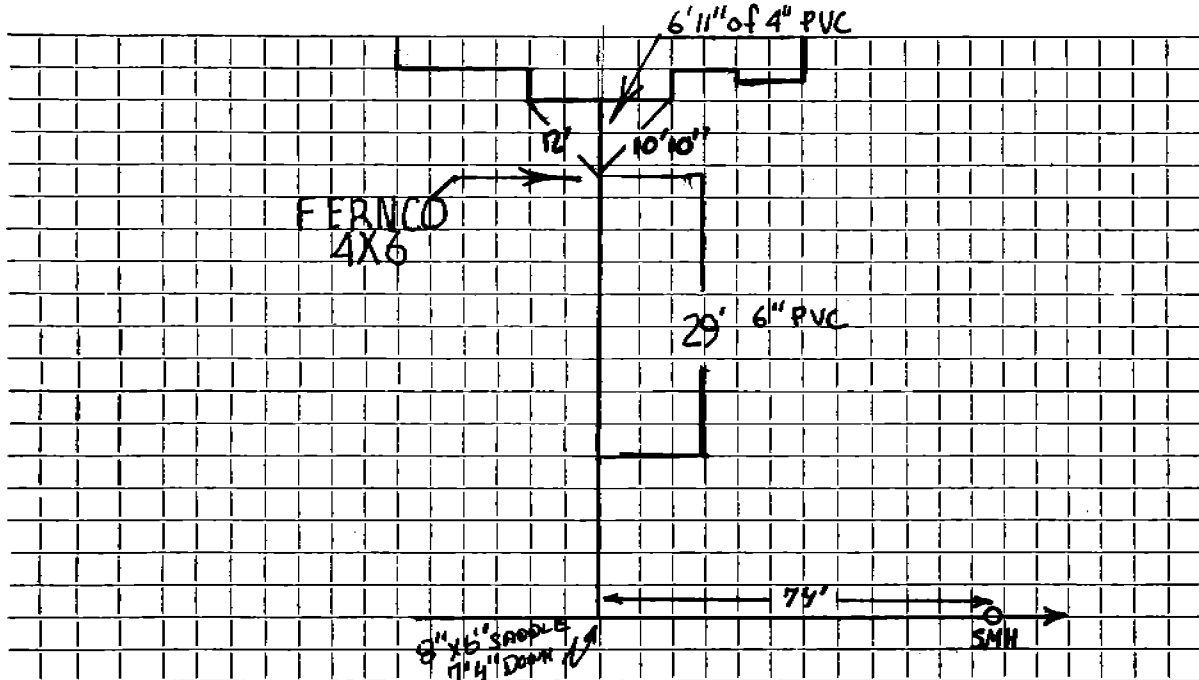

LOT #4

Connection made in Bow S.T. Street. Work completed DEC: 1984

Remarks: .....