


DATE 8/20/19

TOWN OF LEXINGTON — BOARD OF PUBLIC WORKS
SEWER DIVISION

Sketch of Service Here

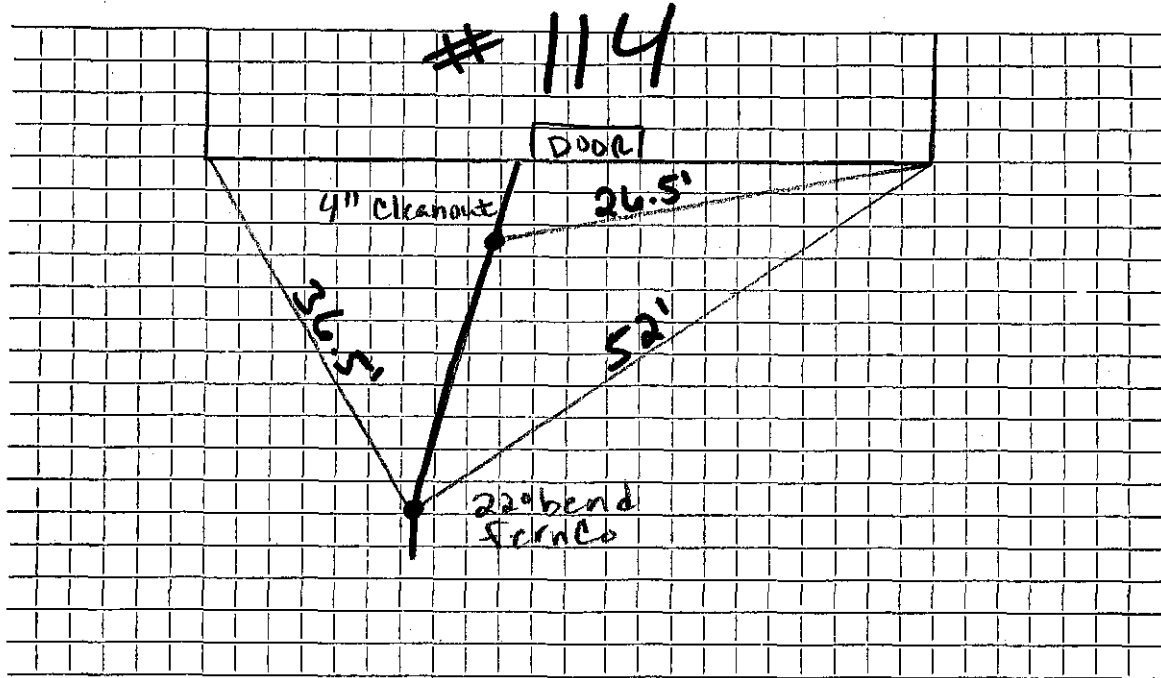

Connection made in Bow Street. Work completed

Remarks:

.....

.....