

Name George S. Grey

Service No. 19

Address 11 Bowker Street

Location

Kind of Pipe

Size

Size of Main

~~Repair/Renewal~~ New Service Valeri #4573


Location SEP 5 1986

Date	Material	Amount	Total	Date	Amount
7/18/86	Labor	39.09		7/21/86	77.60
	10% O.H.	3.91	43.00	Deposit	
20'	6" Transite pipe @.78		15.60		
2	hrs. Town Shovel @ \$6.50		13.00		
1	hr. Trucking @ \$3.00		3.00		
1	hr. Allis Chalmers Dozer @ \$3.00		3.00		
			77.60		
7/28/86	102' 6" P.V.C.				
1	6" Wye C. Out				
1	30° Sweep				
1	4" x 6" Fernco				
1	AC to PVC Adpt.				

DATE \_\_\_\_\_

TOWN OF LEXINGTON — BOARD OF PUBLIC WORKS  
SEWER DIVISION

Sketch of Service Here **11**

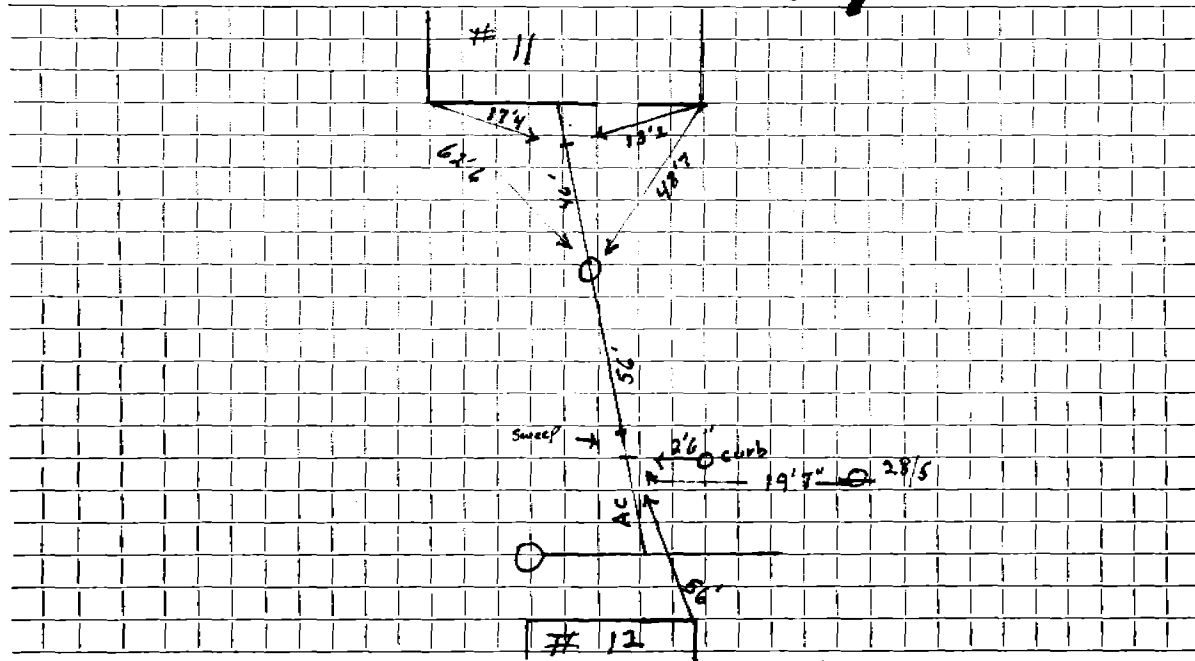

Connection made in ..... Street. Work completed .....

Remarks: .....  
.....  
.....