

Name Madeline L. Taylor

Service No. 9 109

Address 12 Bowker Street, Lexington

Location 12 Bowker Street

Kind of Pipe

Size

Size of Main

Repair—Renewal—New Service

Location

Date
1942

Material

Amount

Total

Date

Amount

5/12/42

34 hrs. @ 60¢ 20 40

15 " @ 65¢ 9 75

11 " @ 75¢ 8 25

10% Overhead

24' 6" Sewer Pipe @ 16¢

1 6" 1/8 Bend 60

Joint compound 1 44

1 load gravel 50

Compressor - 1 hr. 2 25

Tractor - 1/2 hr. 63

Trucking- 2 hrs. @ 75¢ 1 50

53 00

May 6, 1942 Deposited
May 28, 1942 Refund

60.00
7.00

Labor

TOWN OF LEXINGTON—BOARD OF PUBLIC WORKS

SEWER DIVISION

DATE May 6, 1942

NO. _____

The undersigned applies for the construction of a particular sewer connecting No. 12 Bowker Street and hereby agrees to comply with the Rules and Regulations governing the construction and use of Particular Sewers, as now or at any future time established by the Board of Selectmen.

Am't. of Estimate \$ 60.00


Am't. Paid \$ _____

Madelini L. Taylor Owner

12 BOWKER

Sketch of Service Here

12

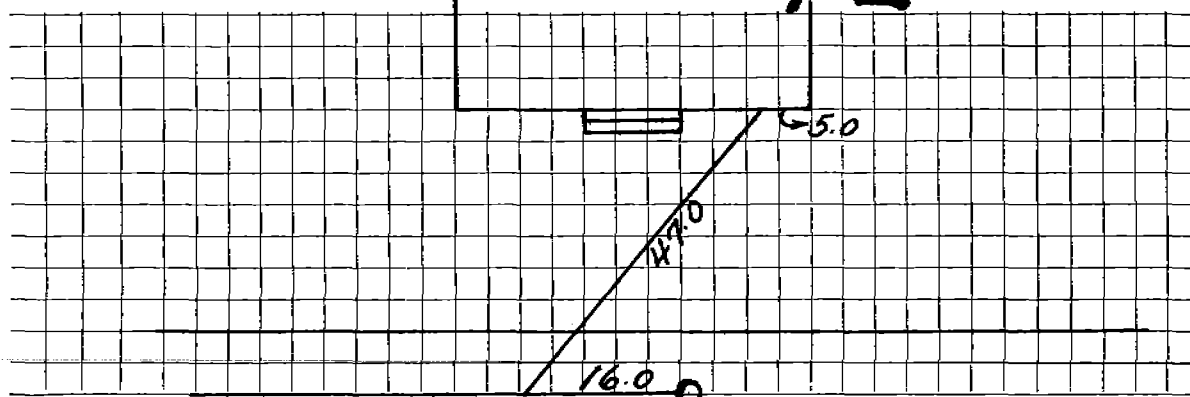

Connection made in _____ Street.

Work completed _____ 19

Remarks: