

DATE _____


TOWN OF LEXINGTON — BOARD OF PUBLIC WORKS

SEWER DIVISION

21 BOWKER

Sketch of Service Here

21

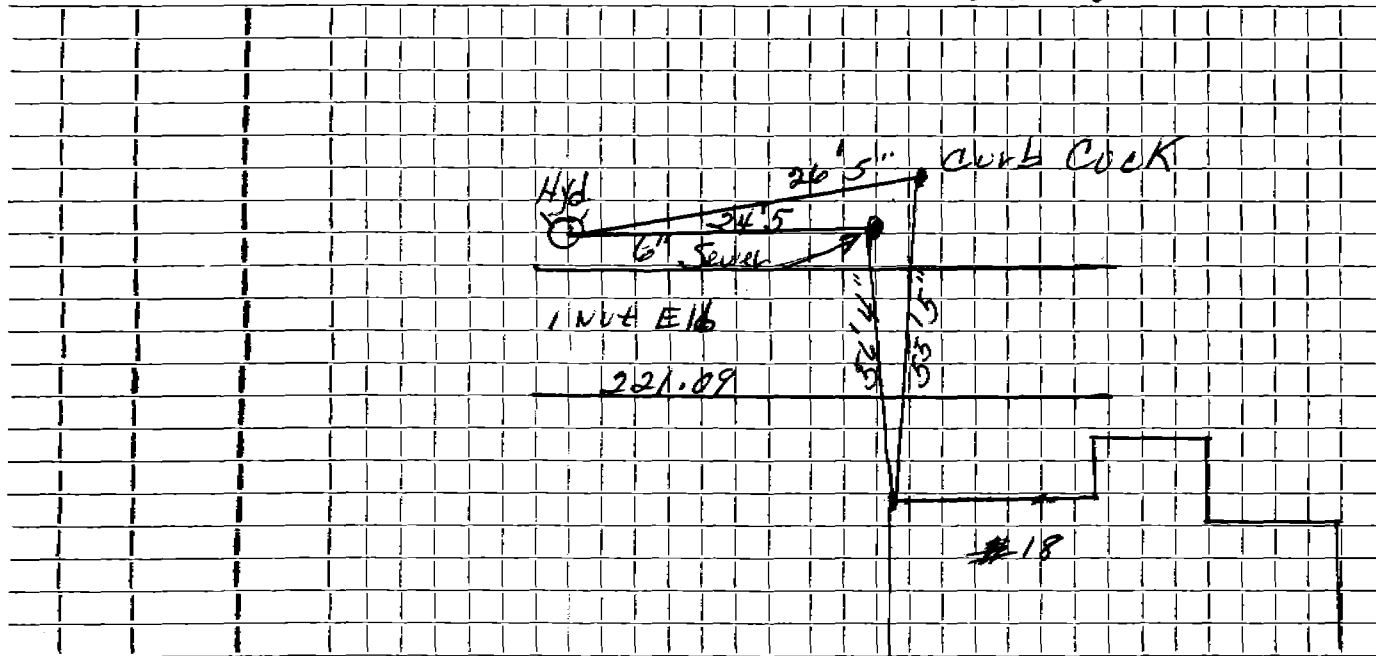

Section made in Street. Work completed

Remarks:

.....
.....