

Name Andera Romagna

Service No. 18

Address #22 BOWMER AVE

Location

Kind of Pipe DEP & PVC

Size 6"

Size of Main 8" VCP

~~Repair~~ ~~Renewal~~ ~~New Service~~ Suburbanite #4174


Location OCT 31 1983

Date	Material	Amount	Total	Date	Amount
7-20-60	Labor	30.64		6-1-83	71.74
	10% O.H.	3.06	33.70	Deposit	
15'	6" Transite pipe @ .78		11.70		
1	22 $\frac{1}{2}$ ^o Transite Elbow		2.24		
1	11 $\frac{1}{2}$ ^o Transite Bend		5.10		
2	hrs. Town Shovel @ 6.50		13.00		
1	hr. Trucking @ 3.00		3.00		
1	hr Dozer @ 3.00		3.00		
			71.74		
6/9/83	90' 6" P.V.C.				
2	22 $\frac{1}{2}$ ^o x 6" Elbow				
2	45 ^o x 6" Elbow				
2	6" Wye				
2	6" P.V.C. Caps				
1	6" x 4" Donut				

DATE JUNE 9, 1983

TOWN OF LEXINGTON — BOARD OF PUBLIC WORKS
SEWER DIVISION

Sketch of Service Here **22**

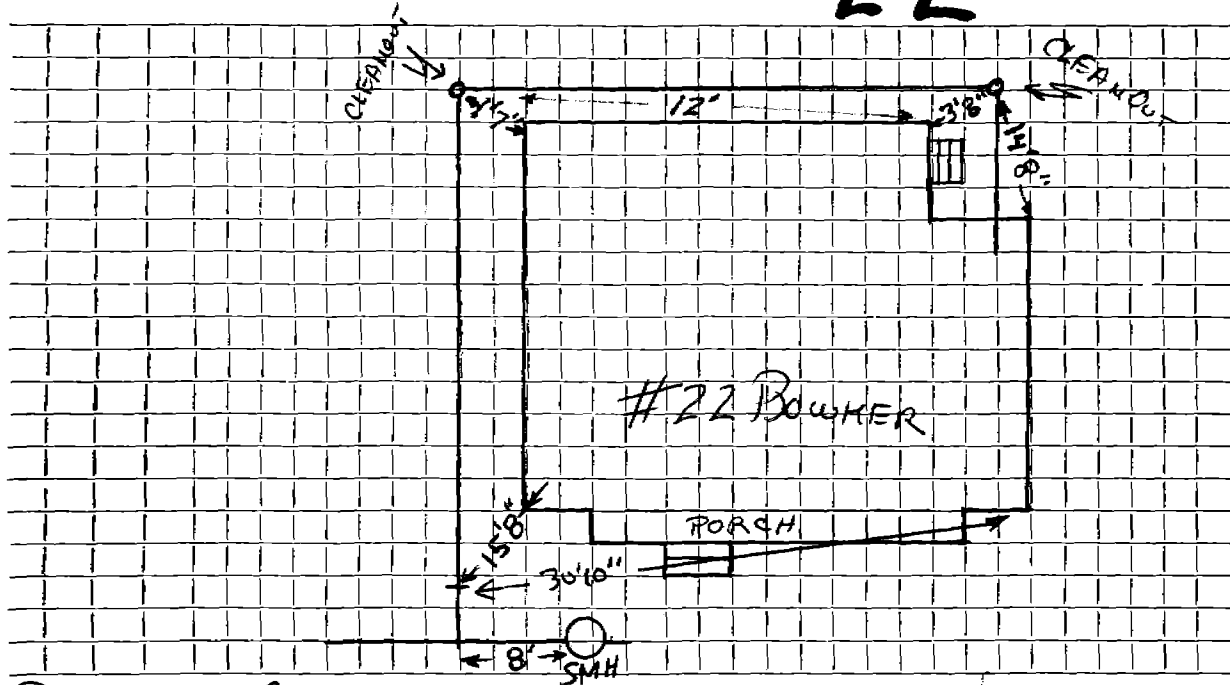

Connection made in BOWMER AVE Street. Work completed JUNE 1983

Remarks: