

Name James Bushard

Service No. 63

Address 25 Bowker Street

Location

Kind of Pipe

Size

Size of Main

Repair General - New Service W.C. 8685

Location Cinn 9-21-64


Date	Material	Amount	Total	Date	Amount
7-20-60	Labor	22 98		4-24-64	300 00
	10% O.L.H.	2 30	25 28	9-21-64	44 60
	24' 6" Transite pipe @ .78		18 72		344 60
	1 6" Transite elbow		5 40		
	2 Hrs. Town shovel @ 6.50		13 00		
	1 Hr. Trucking @ 3.00		3 00		
	1 Hr. Allis chalmers @ 3.00		3 00		
	BILL WHEN CONNECTED		68 40		
6-3-64	Labor 87.00				
6-4-64	" 56.00	143 44			
	10% O.H.	14 34	157 78		
	90' 6" Transite pipe @ .82		73 80	1 6" Duplex Adapter	1 62
	1 Bag Cement		1 50	2 Hrs Town Shovel @ 6.50	13 00
	2 22 1/2° Transite Bend @ 4.09		8 18	2 Hrs Trucking @ 3.00	6 00
	1 11 1/4° Transite Elbow		2 35	4 Yds Loam @ 3.00	12 00
					344 60

DATE \_\_\_\_\_

**TOWN OF LEXINGTON — BOARD OF PUBLIC WORKS**  
**SEWER DIVISION**

Sketch of Service Here

**25**

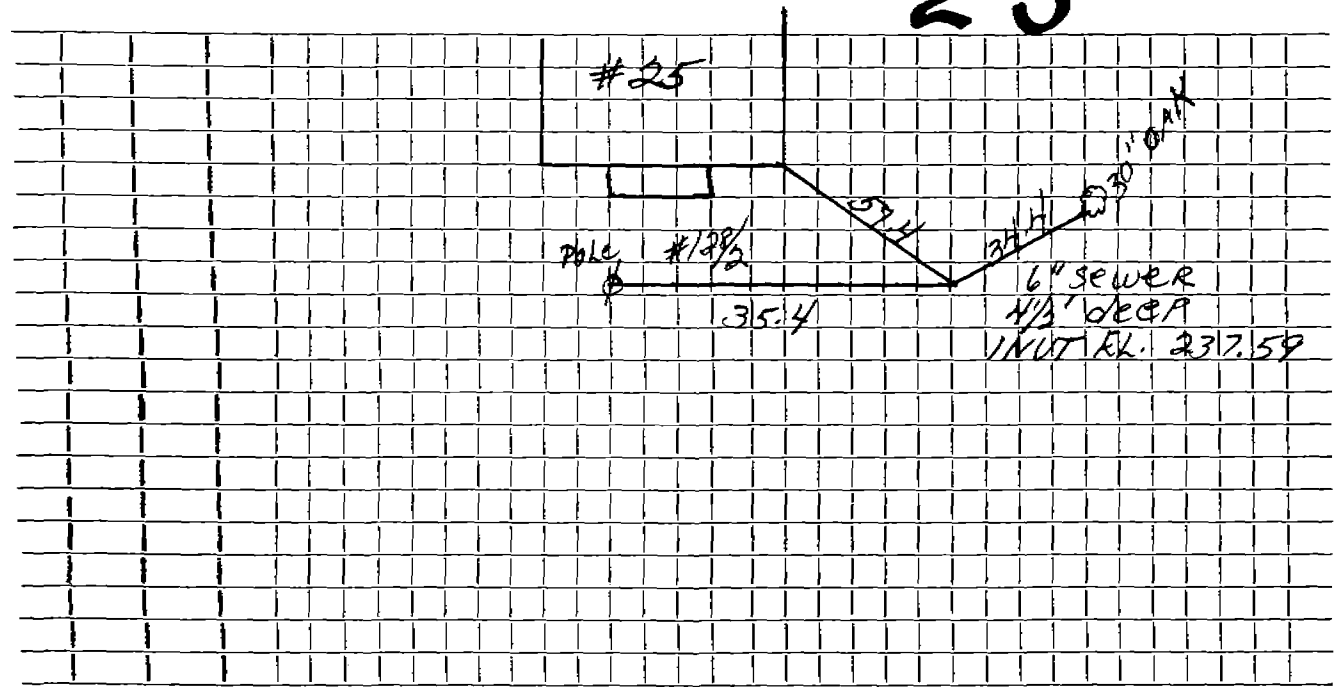

Connection made in ..... Street. Work completed .....

Remarks: .....

.....

.....