

Name

Service No.

Address 26 BOWKER ST

Location

Kind of Pipe

Size

Size of Main


Repair—Renewal—New Service McLaughlin

Location

Date	Material	Amount	Total	Date	Amount
7/20/60	14' 6" TRANSITE				
	1 6" 90° TRANSITE EL				
APRIL 2000	47' 6" PVC				
	5' 4" PVC				
	1 4X6 FERNOCO				
	1 6" A CX PVC FERNOCO				
	1 45° BEND				

DATE \_\_\_\_\_

TOWN OF LEXINGTON — BOARD OF PUBLIC WORKS  
SEWER DIVISION

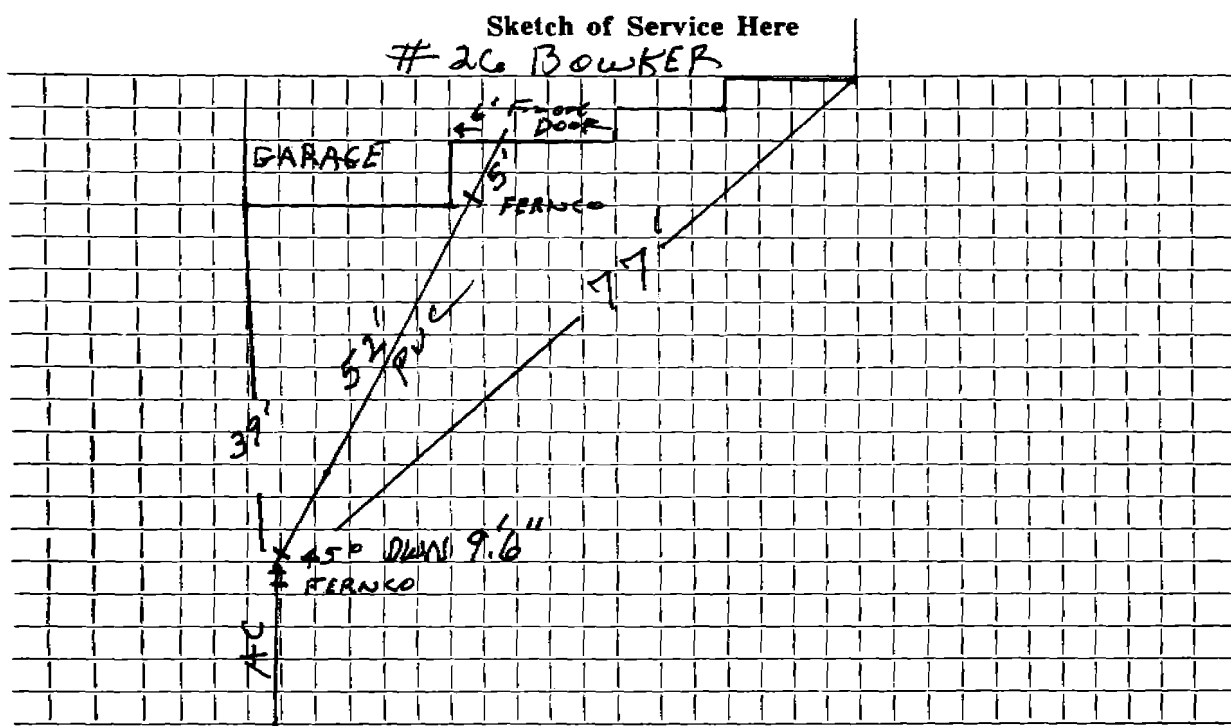

Connection made in ..... Street. Work completed .....

Remarks: .....  
.....  
.....