

Name Virginia P. Ryder

Service No. 66

Address 30 Bowker Street

Location

Kind of Pipe

Size

Size of Main

~~Repair - Renewal~~ New Service John E. Grant Permit #308

Location

OCT 25 1965


Date	Material	Amount	Total	Date	Amount
7-22-60	Labor	52 77		5-28-65	101 81
	10% O.H.	5 28	58 05		
	14' 6" Transite pipe@.78		10 92		
	1 11 <sup>10</sup> / <sub>4</sub> " Transite bend		5 10		
	1 22 <sup>10</sup> / <sub>2</sub> " Transite elbow		2 24		
	3 Hrs. Twon shovel:6.50		19 50		
	1 Hr. Trucking@3.00		3 00		
	1 Hr. Allis Chalmers@3.00		3 00		
	BILL WHEN CONNECTED		101 81		
6-28-65	27' 6" Transite pipe				

DATE \_\_\_\_\_

**TOWN OF LEXINGTON — BOARD OF PUBLIC WORKS**  
**SEWER DIVISION**

Sketch of Service Here

**30**

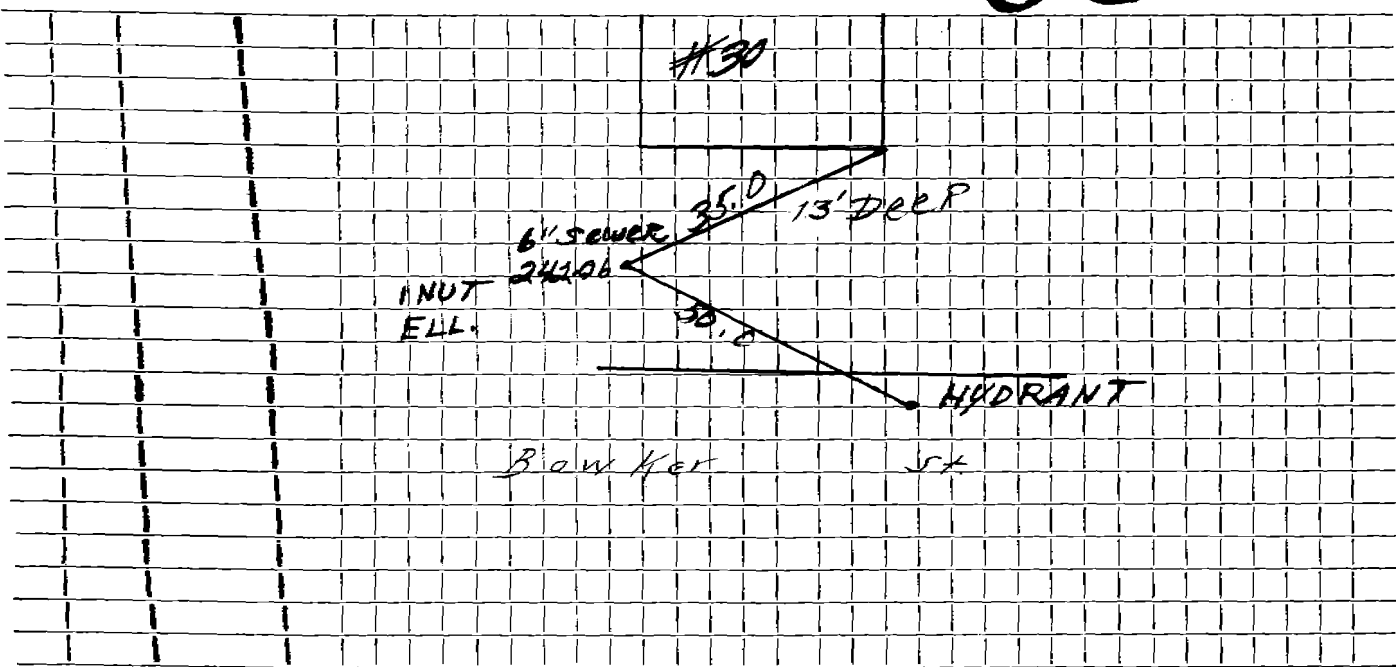

Connection made in ..... Street. Work completed .....

Remarks: .....