

Name John L. Meaney

Service No. 152

Address 31 Bowker Street

Location

Kind of Pipe

Size

Size of Main

~~Repair~~ ~~Renewal~~ - New Service

Location

Conduit

Date	Material	Amount	Total	Date		Amount
7-27-60	Labor	45.20		8-1-60	Deposit	150.00
	10% O.H.	4.52	49.72	10-24-60	Deposit Returned	
	24' 6" Tra site Pipe @.78		18.72			149.72
	1 6" Transite 90° Elbow		5.40		NON CHARGE	
	2 hrs. Town Shovel @6.50		13.00	8-9-60	Labor	75.00
	1 hr. Trucking @3.00		3.00			
	1 hr. Allis Chalmers @3.00		3.00			
	BILL WHEN CONNECTED		92.84			
8-9-60	Labor	9.70				
	10% O.H.	.97	10.67			
	22' XXIX 6" Transite pipe @.78		17.16			
	1 11 1/4° Transite Bend		5.10			
	1 22 1/2° Transite Bend		6.21			
	3 Duplex Adapter @1.90		5.70			
	1 22 1/2° Transite Elbow		2.24			
	1 hr. Town Shovel @6.50		6.50			
	1 hr. Trucking @3.00		3.00			
			149.42			


DATE _____

TOWN OF LEXINGTON — BOARD OF PUBLIC WORKS

SEWER DIVISION

Sketch of Service Here

31

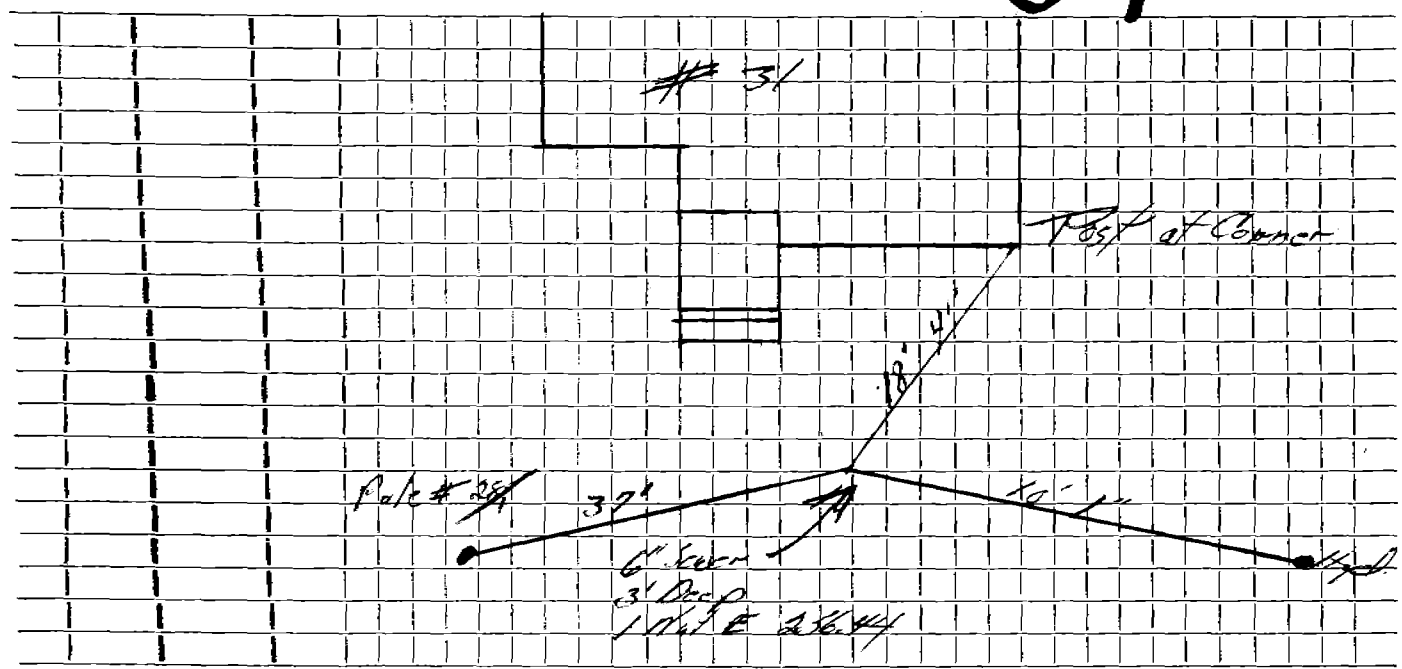

Connection made in _____ Street. Work completed _____

Remarks: _____

