

Name

Service No.

Address 35 Bowker Street

Location

Kind of Pipe

Size

Size of Main

Repair—~~REPAIR~~ ~~NEW~~ ~~SEWER~~

Location

Date

Material

Amount

Total

Date

Amount

11-4-36

28' 6" Sewer Pipe

NON CHARGE

2/4/54 Labor

22 1'

20' - 6" sewer pipe @ .3087

6 1'

joint compound

1 20

4 2/3 hrs. Littlefield shovel

@ 7.50 35 00

2 hrs. trucking @ .75

1 50

patching 6 x 3

6 00

72 04

Labor

TOWN OF LEXINGTON—DEPT. OF PUBLIC WORKS  
SEWER DIVISION

DATE .....

NO. ....

The undersigned applies for the construction of a particular sewer connecting No. ....  
Street and hereby agrees to comply with the Rules and Regulations governing the construction and use of Particular  
Sewers, as now or at any future time established by the Board of Selectmen.


Am't of estimate \$ . . . . .

Am't Paid \$ . . . . .

..... Owner

Sketch of Service Here

35

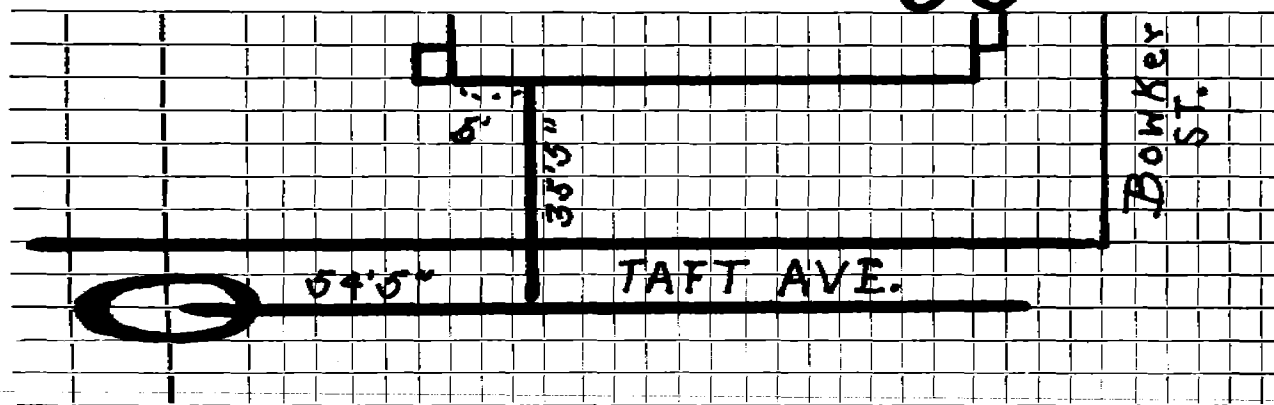

Connection made in ..... Street.

Work completed ..... 19..

Remarks:

